


# T.1N.R.5W.W.M.

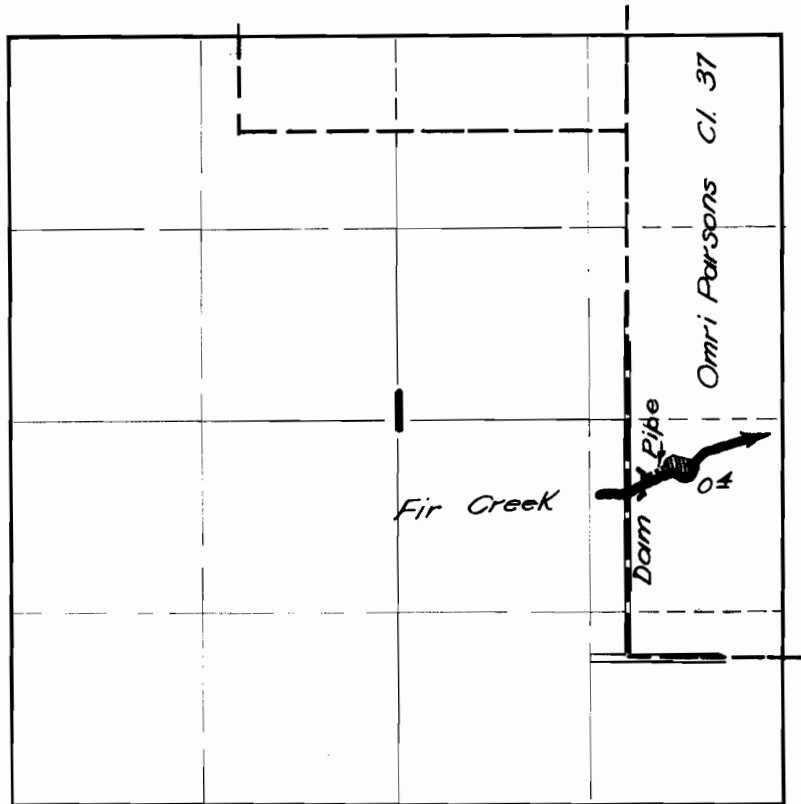

## FINAL PROOF SURVEY

UNDER

Application No. 23333 Permit No. 18394

IN NAME OF

WASCO EARL WANLESS

Surveyed 7 / 15 1952, by H. L. COFFMAN