


T.13 S.R.1 W.W.M.

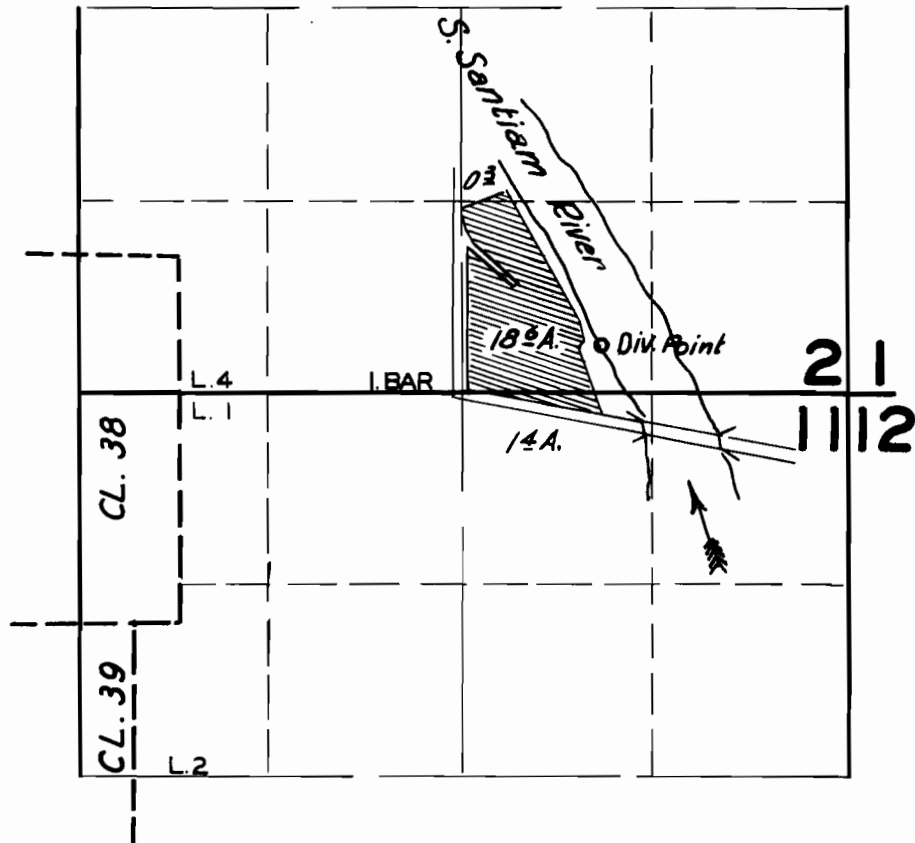

FINAL PROOF SURVEY UNDER

Application No. **23.360**. Permit No. **18681**....
IN NAME OF

.....
W. A. BATES
.....

Surveyed APR. 19 1951, by H. L. COFFMAN