


T.1S.R.4E.W.M.

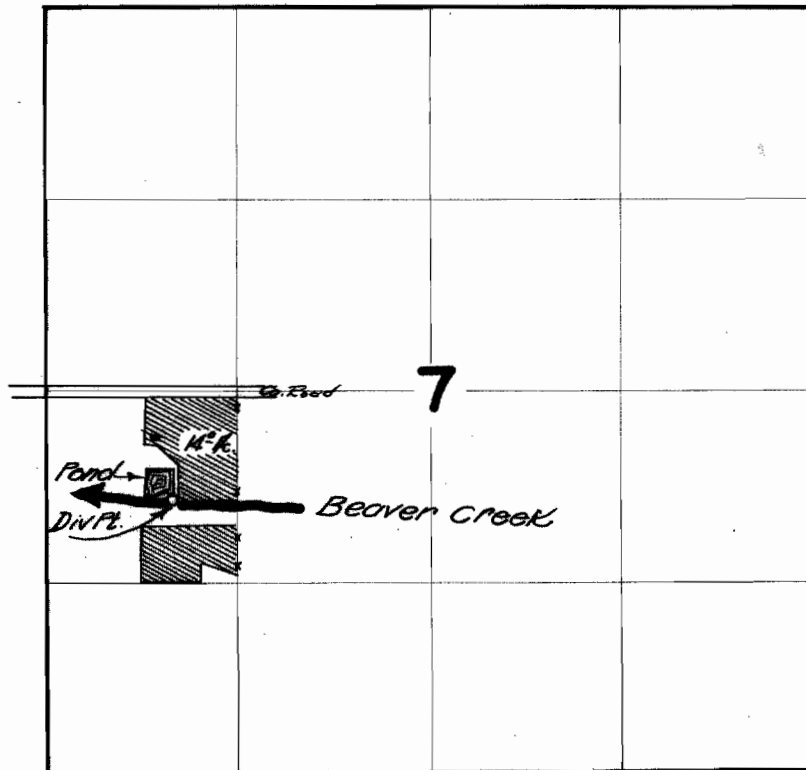

FINAL PROOF SURVEY

UNDER

Application No. 23369 Permit No. 18408

IN NAME OF

W. S. FIELD

Surveyed 10/16 1951 H. L. COFFMAN