


# T.2S.R.3W.W.M.

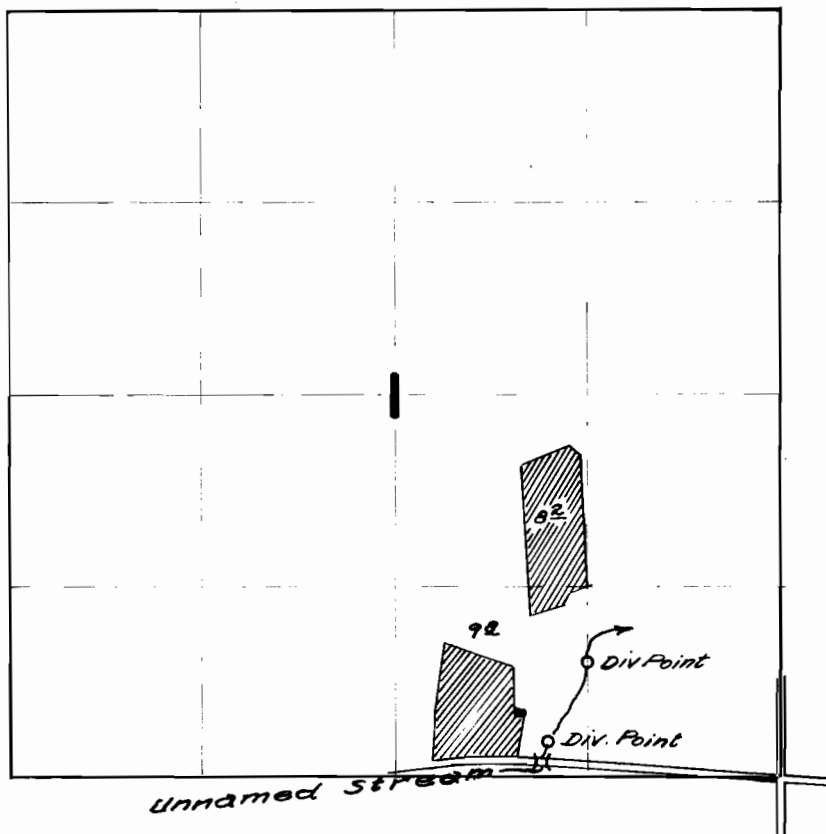

## FINAL PROOF SURVEY UNDER

Application No. 23507 Permit No. 18533

IN NAME OF

HERMAN EGGER

Surveyed 5 / 5 1952, by H. L. COFFMAN