


T5S.R.5W.W.M.

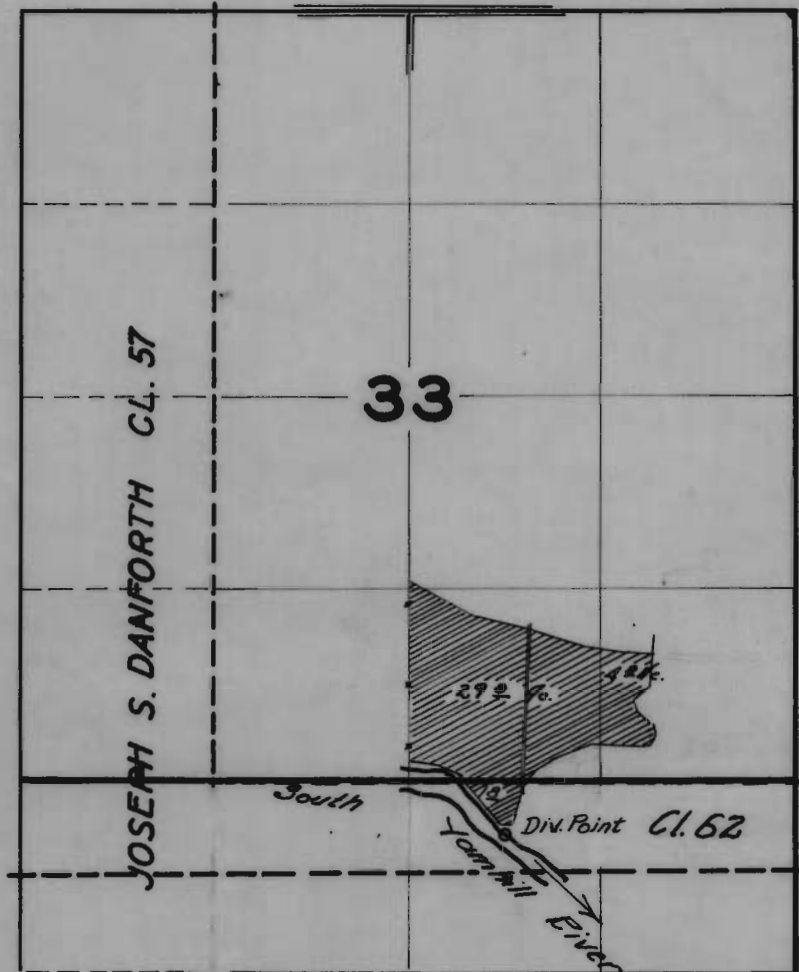

FINAL PROOF SURVEY

UNDER

Application No. **23532**. Permit No. **18584**.

IN NAME OF

JOHN DE JONG

Surveyed **9/25**, 1951, by **H.L. COFFMAN**