


# T.1S.R.3W.W.M.

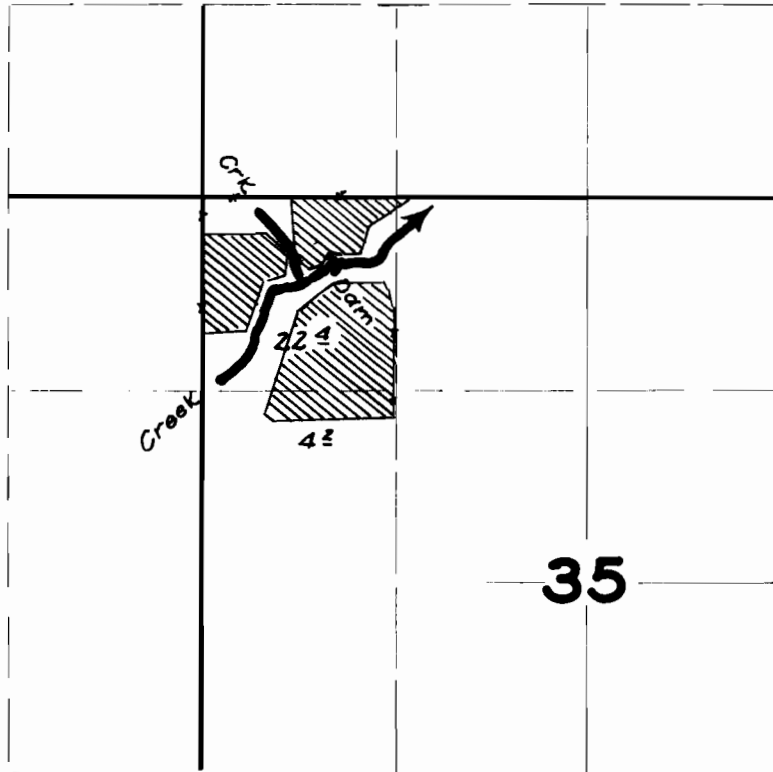

## FINAL PROOF SURVEY

UNDER

Application No. 23621 Permit No. 18625

IN NAME OF

EARL W. WAINLAUGH & PERCY O. JARRELL

Surveyed May 8, 1952, by H. S. COFFMAN