


T. 6 S. R. 1 W. W. M.

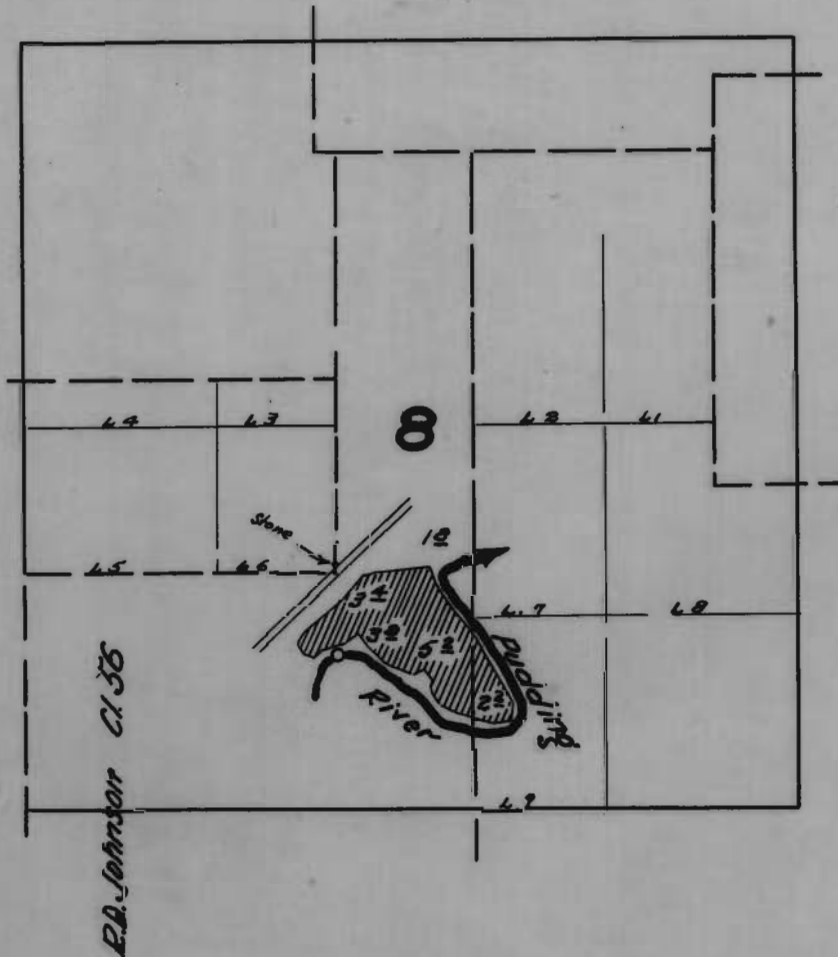

FINAL PROOF SURVEY UNDER

Application No. 23636 Permit No. 18691
IN NAME OF

W. DOUGLAS HARRIS

Surveyed Aug. 21, 1952, by H. L. COFFMAN