


T. 15. R. 4 & 3 W. W. M

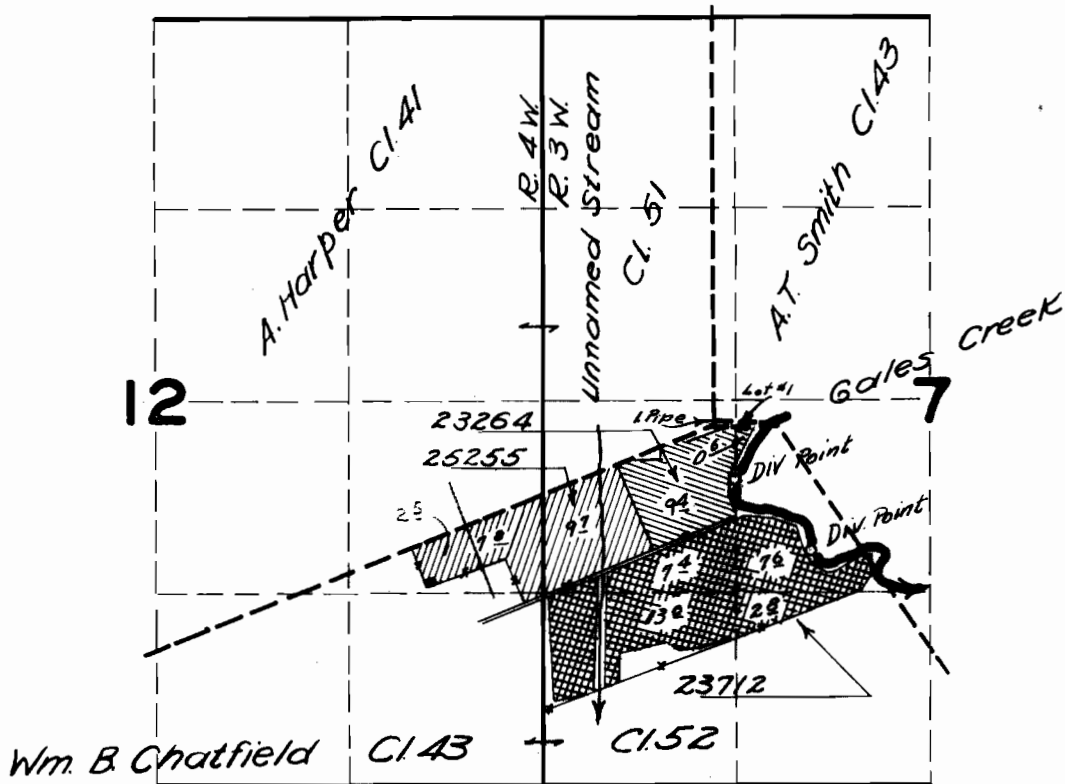

FINAL PROOF SURVEY

23264 & 18430 &

25255 19840

Application No. 23712 Permit No. 18725

IN NAME OF

IVAN M. & EDITH R. AVENT
MARTIN EDWARD GERDES

Surveyed May 21, 1952, by H. L. COFFMAN