


T.I.S.R.3 W.W.M.

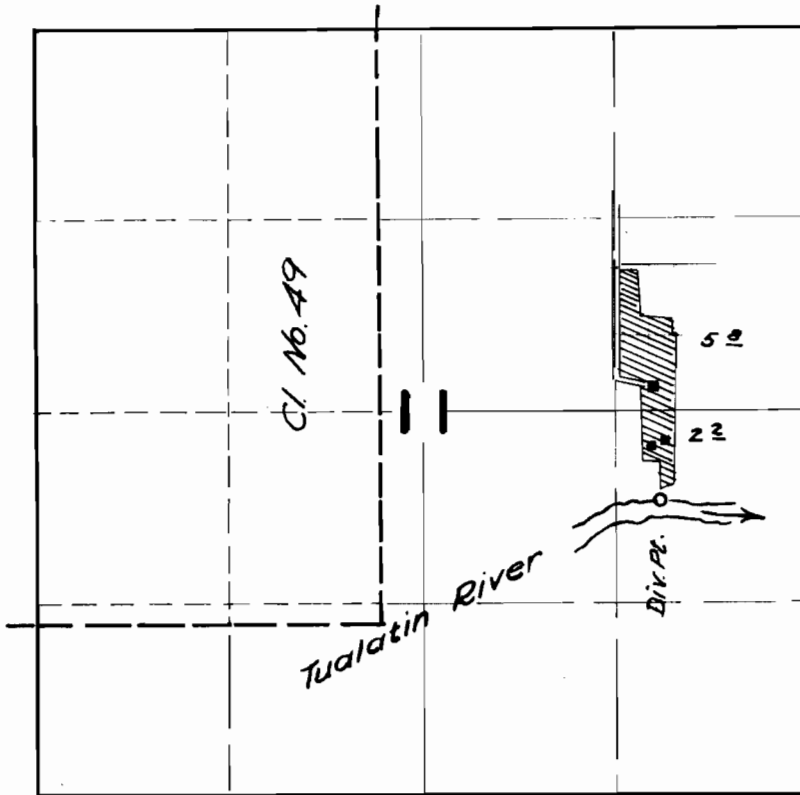

FINAL PROOF SURVEY

UNDER

Application No. 23725 Permit No. 18736

IN NAME OF

E. G. GILL

Surveyed May 19, 1952, by H. L. COFFMAN