


T. 10S. R. 3 W. W.M.

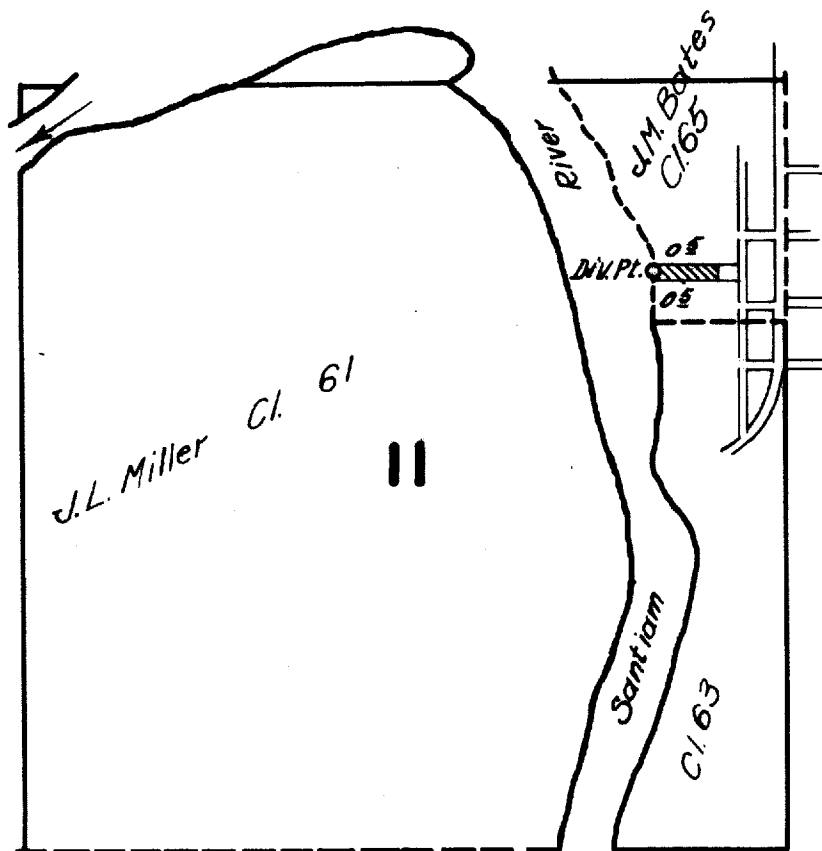

**FINAL PROOF SURVEY**

UNDER

Application No. 23861 Permit No. 18825

IN NAME OF

PAUL J. & ADA M. MC KEE

Surveyed July 31 1952, by H. L. COFFMAN

1952 E