
T.IS.R.Q.W.W.M.

RECEIVED

SEPS 1974 STATE ENGINEER SALEM OREGON

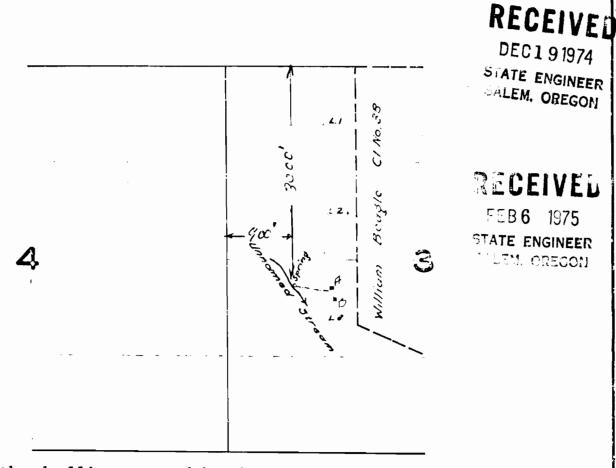

Item "A" is the dwelling covered by the original water right Certificate in Volumbe 14, page 20109

Item "B" is the dwelling KENK (second) where the water flows from item A to item B.

FINAL PROOF SURVEY

Application No. 24033.... Permit No. 18947... IN NAME OF

ACCOUNTED AUSTIN & COTHER M. AUSTIN

Surveyed 4/17/1952, by ... I. C. W. T.

Application No. 52388 Permit No. 39412