


T.4S.R.1W.W.M.

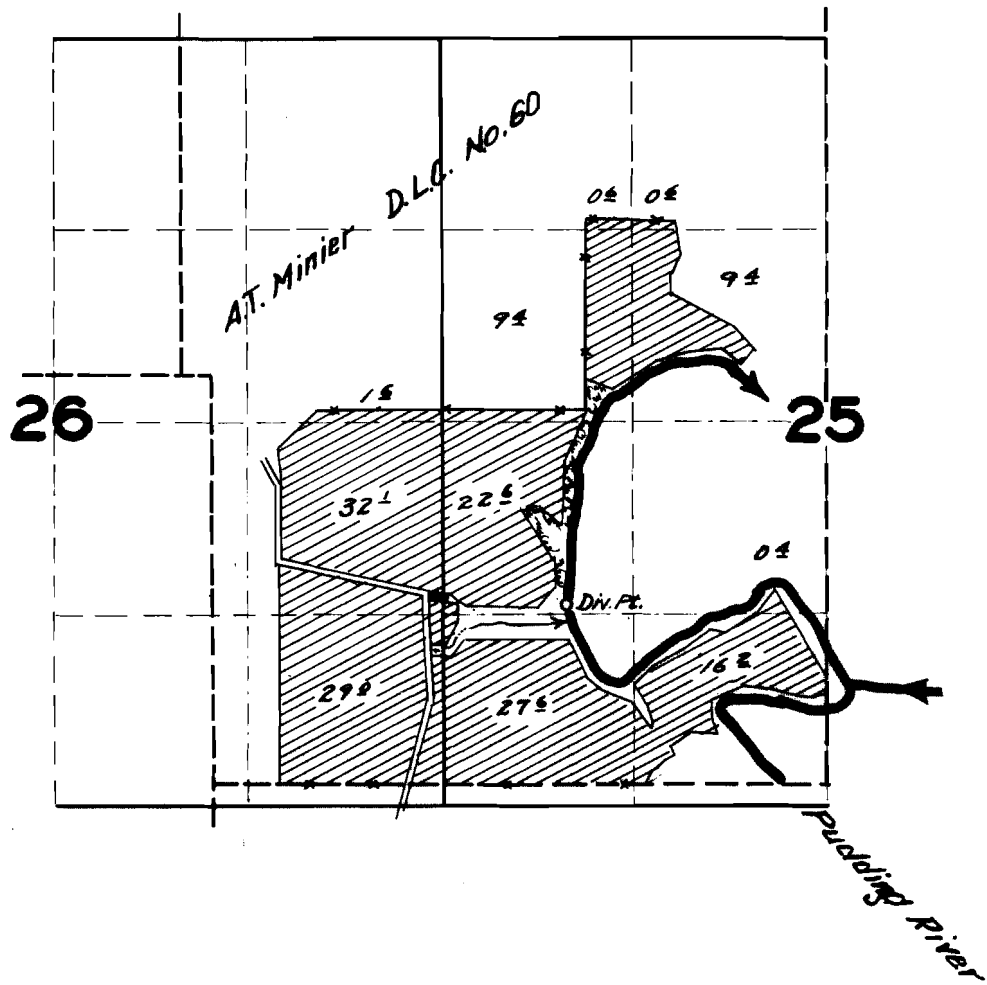

FINAL PROOF SURVEY UNDER

Application No. 24106 Permit No. 18981

IN NAME OF

WILLIAM FOBERT

Surveyed 9 / 16 1952, by H. L. COFFMAN