


T.2S.R.5W.W.M.

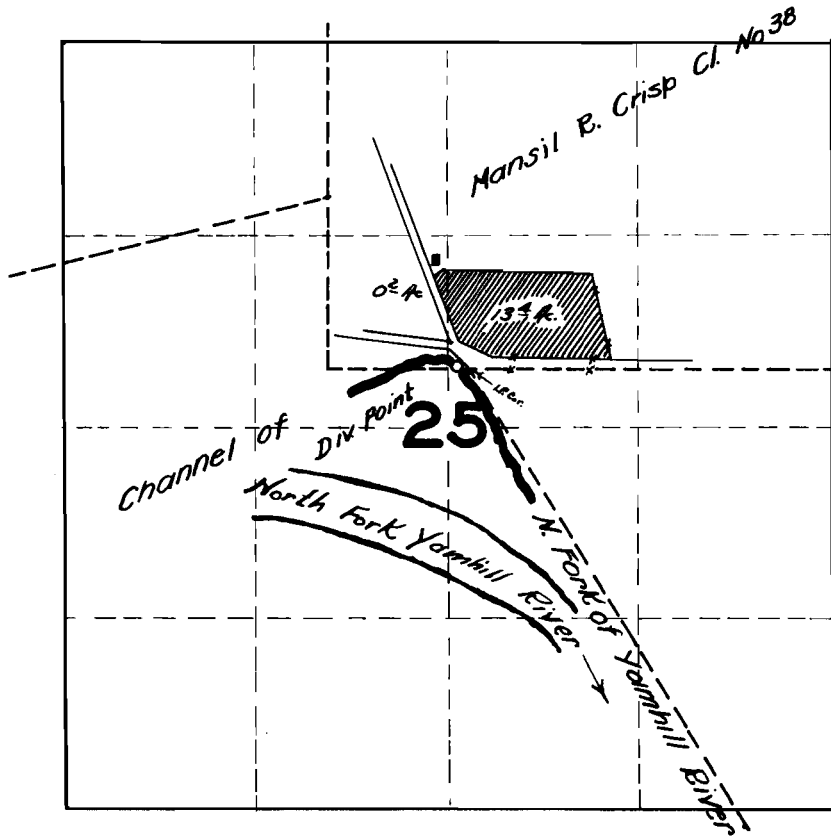

FINAL PROOF SURVEY

UNDER

Application No. 24269.. Permit No. 19047 ...

IN NAME OF

FRANK GEISLER

Surveyed 10/7/1951, by H.L. COFFMAN.