


T.14S. R.1E.W.M.

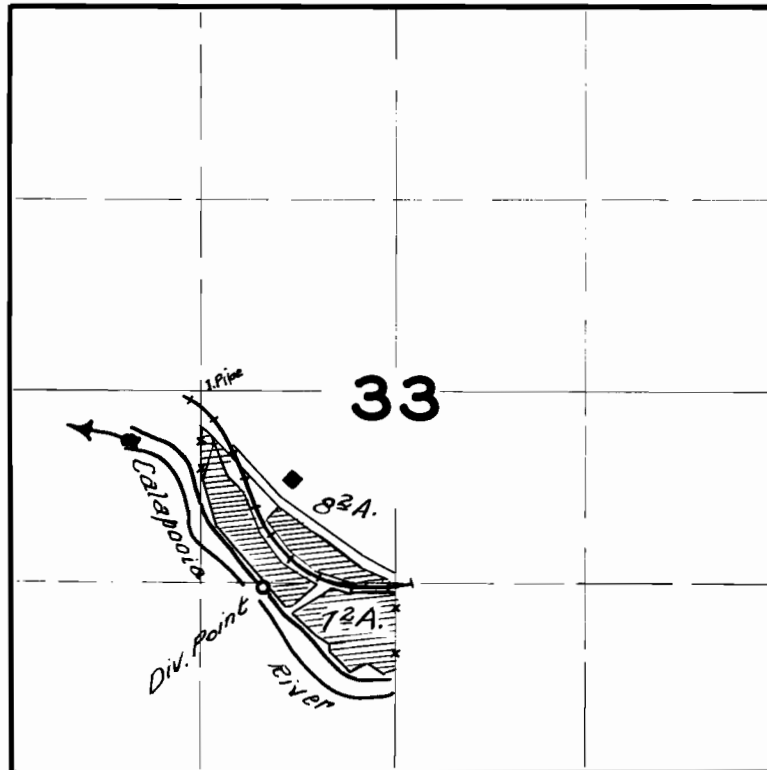

FINAL PROOF SURVEY
UNDER

Application No. 24596 Permit No. 19378.....
IN NAME OF

RALPH E. & ELVERA M. HARGETT

Surveyed APR. 25, 1951, by H.L. COFFMAN