


T.IN.R.3,4 W.W.M.

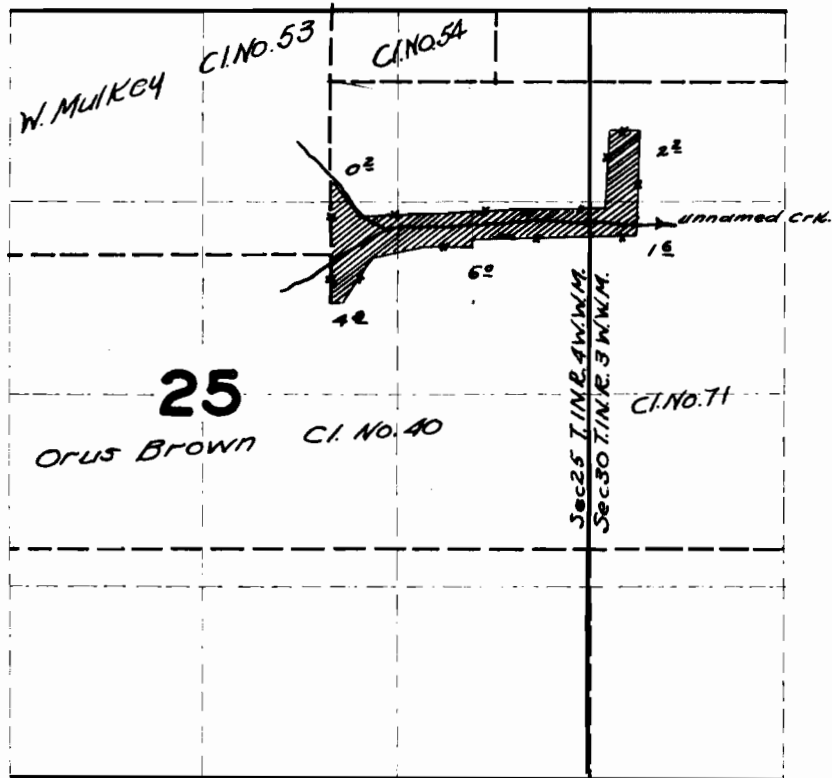

FINAL PROOF SURVEY UNDER

Application No. 23923 Permit No. 18900
IN NAME OF

GEORGE SPIESSCHAERT & F. A. VANAKEN

Surveyed 4 / 23 19 52, by H. L. COFFMAN