


# T.I.S.R.I.W.W.M.

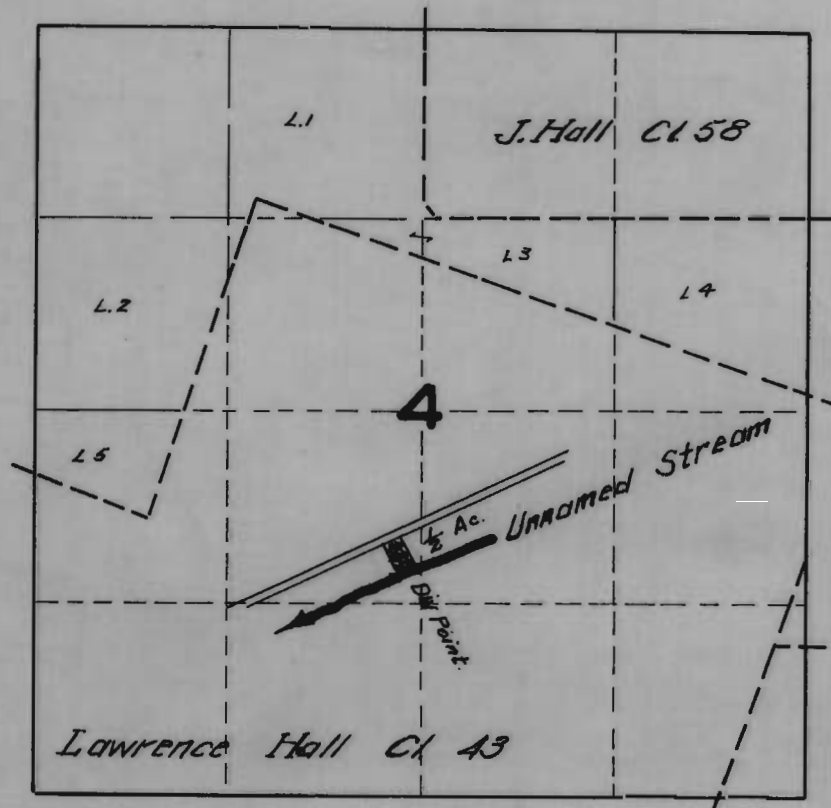

## FINAL PROOF SURVEY UNDER

Application No. 24099 Permit No. 18977

IN NAME OF

R. M. CORNWELL

Surveyed June 5, 1952, by H. L. COFFMAN