


# T.IN.R.3 W.W.M.

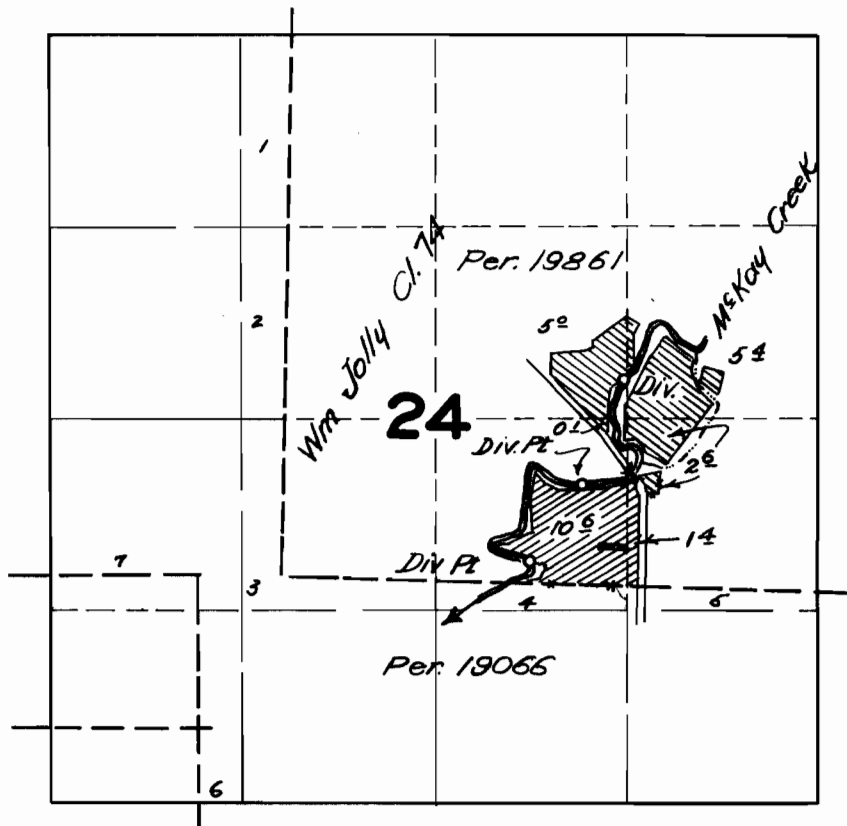

## FINAL PROOF SURVEY

UNDER

24329

19066

Application No. 25306

Permit No. 19861

IN NAME OF

WILLIAM M. REEDY

J. A. JAROSS

Surveyed 6 / 12 19 52, by H.L. COFFMAN