


# T.IN.R.3 W.W.M.

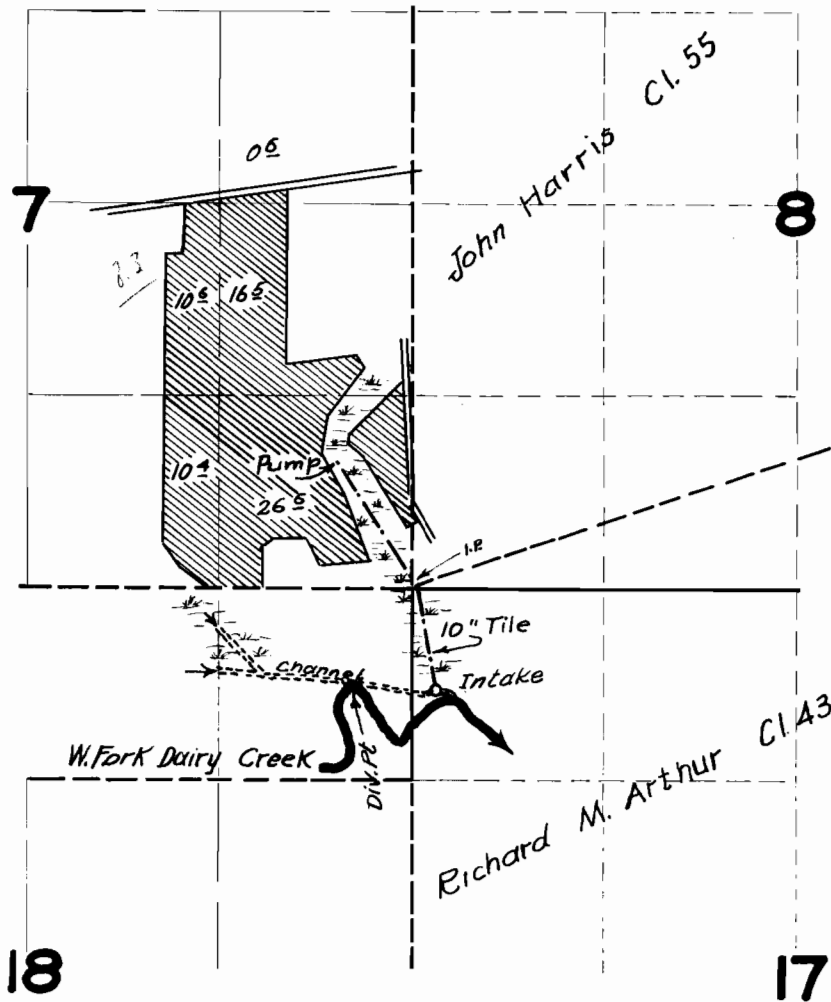

## FINAL PROOF SURVEY

UNDER

Application No. 24189 Permit No. 19020

IN NAME OF

LOUIS E. SPERING

Surveyed June 2, 1952, by A. L. COFFMAN