


# T.1N.,R.4W.,W.M.

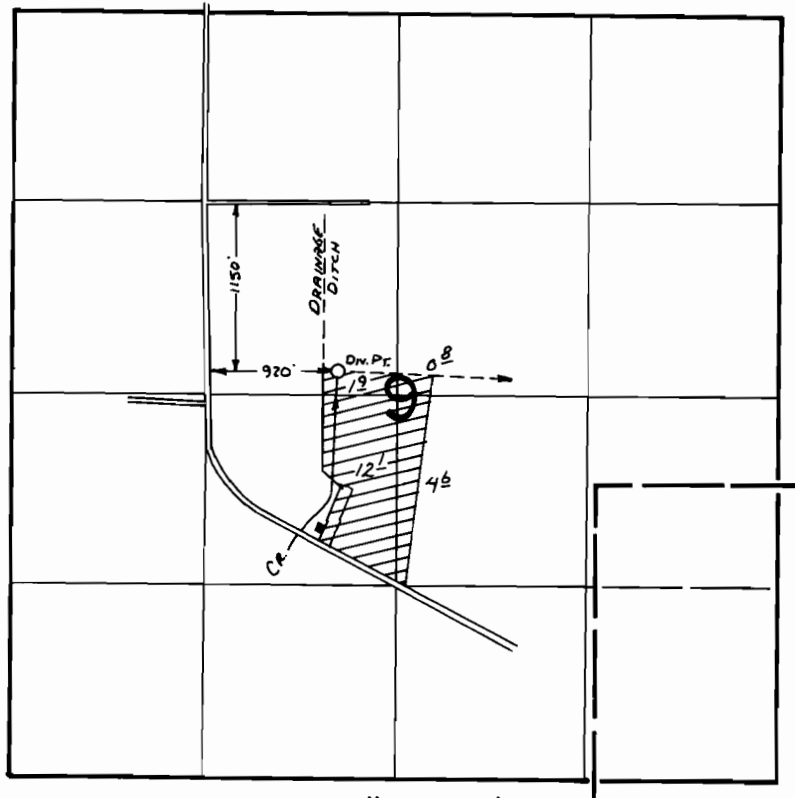

SCALE: 1" = 1320'

## FINAL PROOF SURVEY UNDER


Application No. 24237... Permit No. 19209.....  
IN NAME OF

.....**HOWARD M. ROBERTSON**.....

Surveyed July...11... 1952., by H.L. COFFMAN....

Superseded  
3/8/84

T.1N.R.4W.W.M.

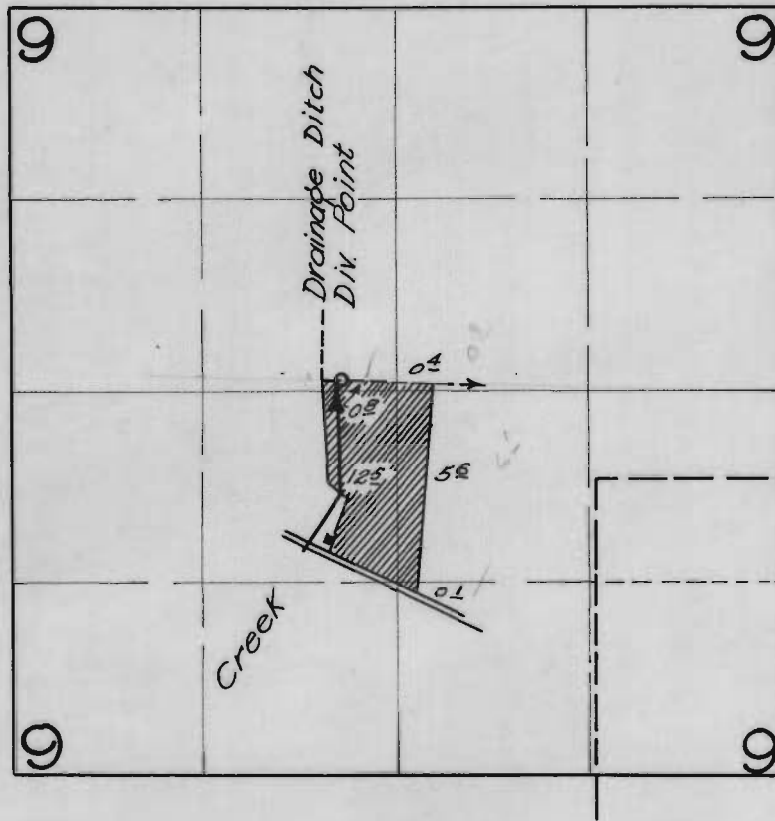

**FINAL PROOF SURVEY**  
UNDER

Application No. 24237 Permit No. 19209  
IN NAME OF

.....  
HOWARD M. ROBERTSON  
.....

Surveyed 7 / 11 19 52, by H. L. COFFMAN