


# T.2N.R.4W.W.M.

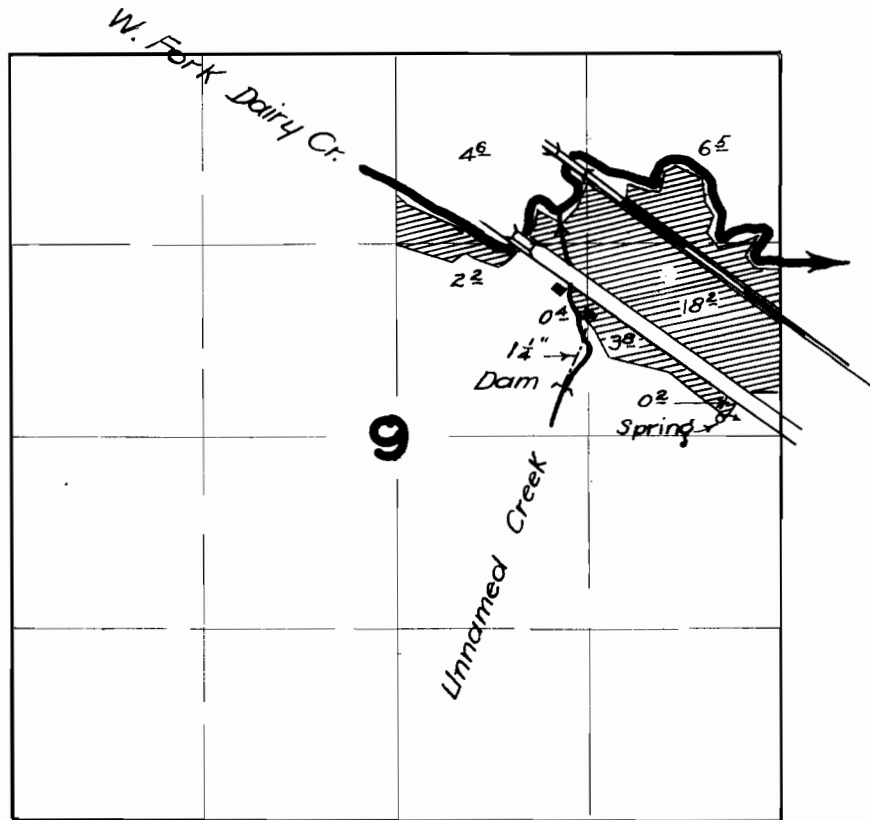

## FINAL PROOF SURVEY

UNDER

Application No. 24394 Permit No. 19242

IN NAME OF

JOHN SEDERCRIST

Surveyed 7 / 8 1952, by H. L. COFFMAN