


T.2N.R.4W.W.M.

Sunset Hwy
W. Dairy Creek

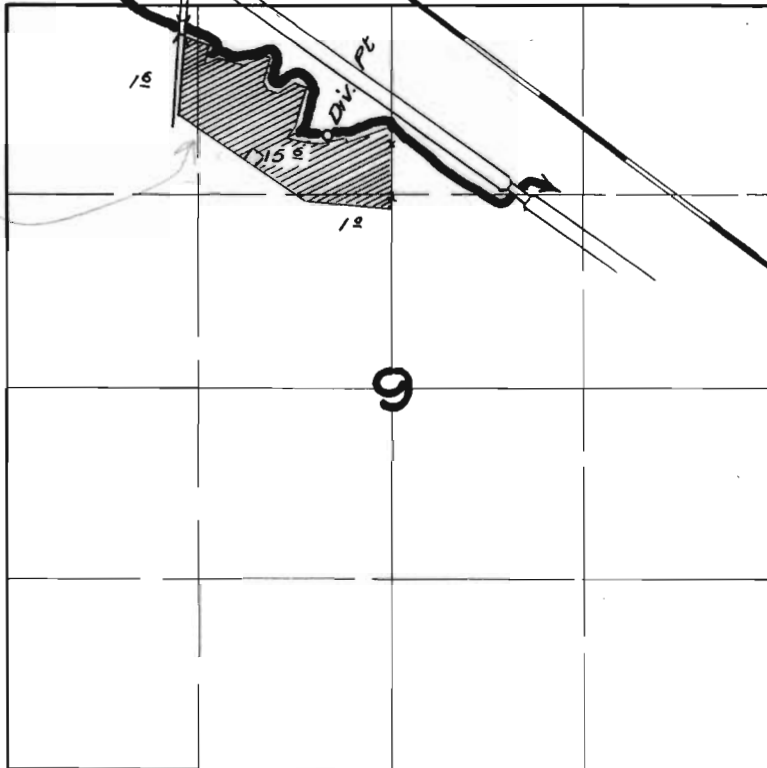

AD's
Wrong?
see file 4194
& Burton and

FINAL PROOF SURVEY

UNDER

Application No. 24453 Permit No. 19277

IN NAME OF

W. M. MIZNER

Surveyed 7 / 1 1952, by H. L. COFFMAN