


# T. I. S. R. I W. W. M.

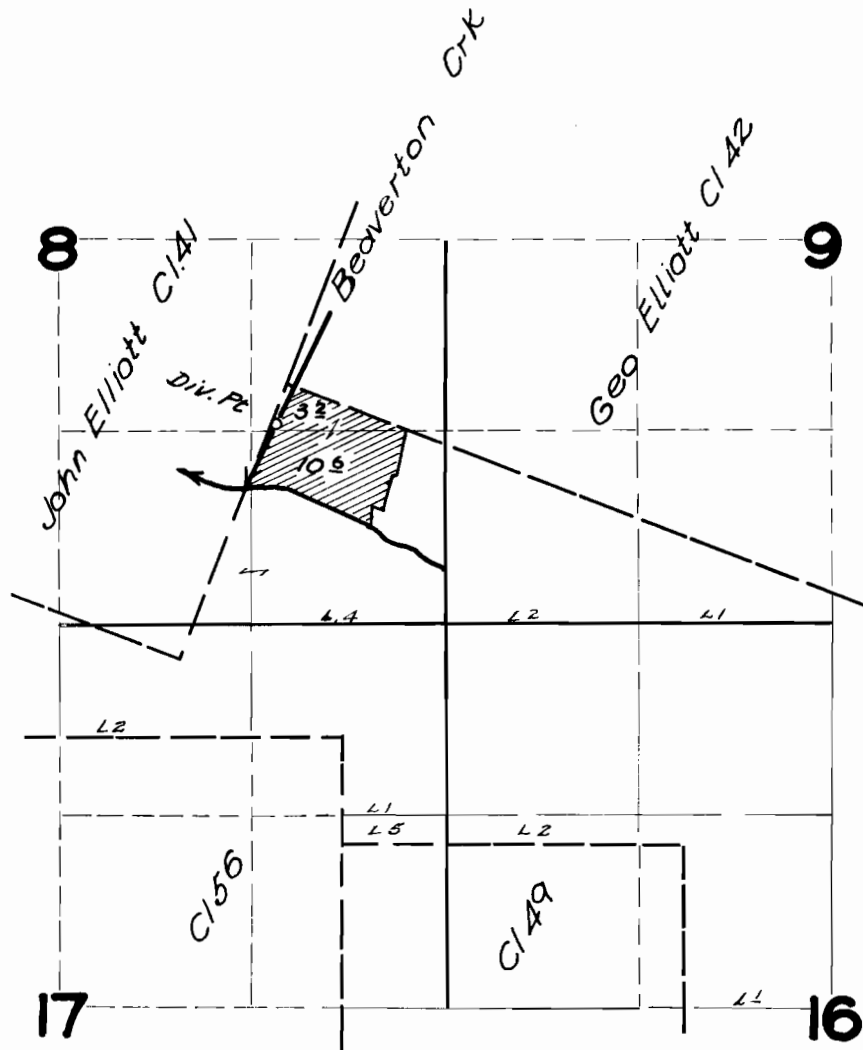

## FINAL PROOF SURVEY

UNDER

Application No. 24523 ... Permit No. 19355

IN NAME OF

ST. ... ST. ...

Surveyed: June 14, 1952, by ...