


# T.I.S.R.2W.W.M.

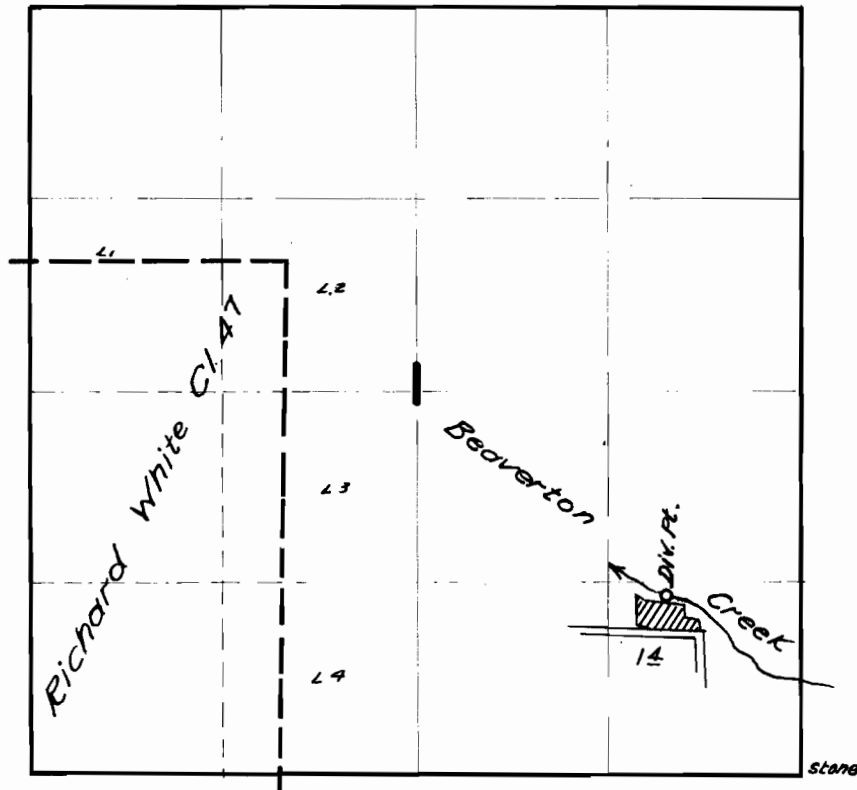

## FINAL PROOF SURVEY

UNDER

Application No. 24554 Permit No. 19361

IN NAME OF

MORRIS EUGENE WILSON

Surveyed June 5, 1952, by H. L. COFFMAN