


# T.2S. R2 W.W.M.

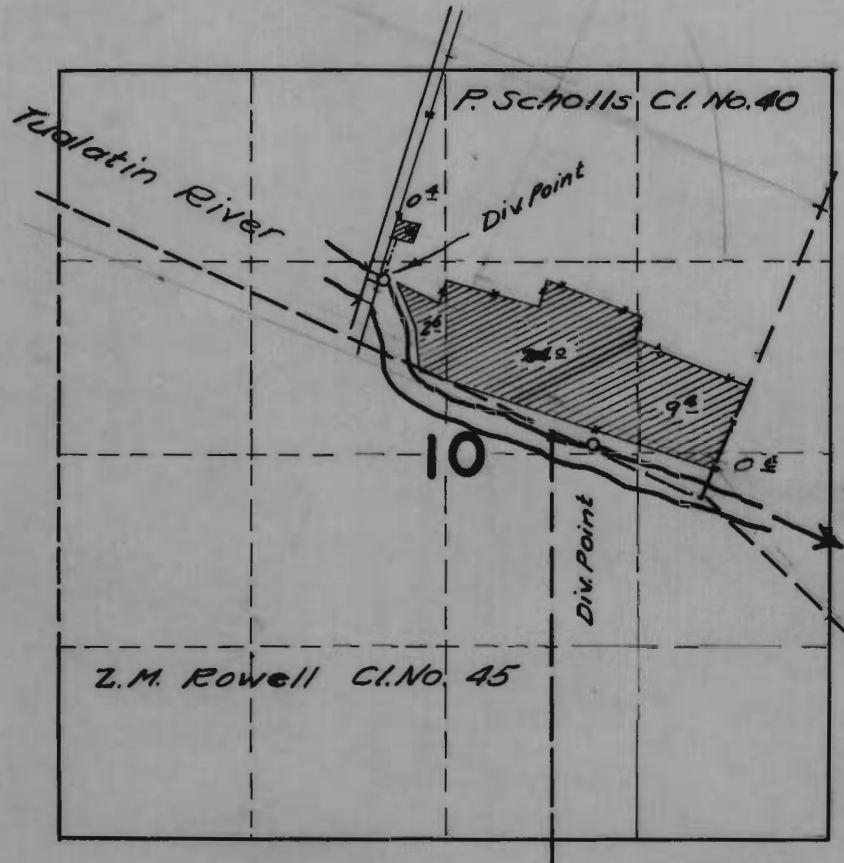

## FINAL PROOF SURVEY

UNDER

Application No. 24789 Permit No. 19529

IN NAME OF

LYLE D. GOODELL

Surveyed 5 / 2 1952, by H. L. COFFMAN