


# T. I. S. R. | W. W. M.

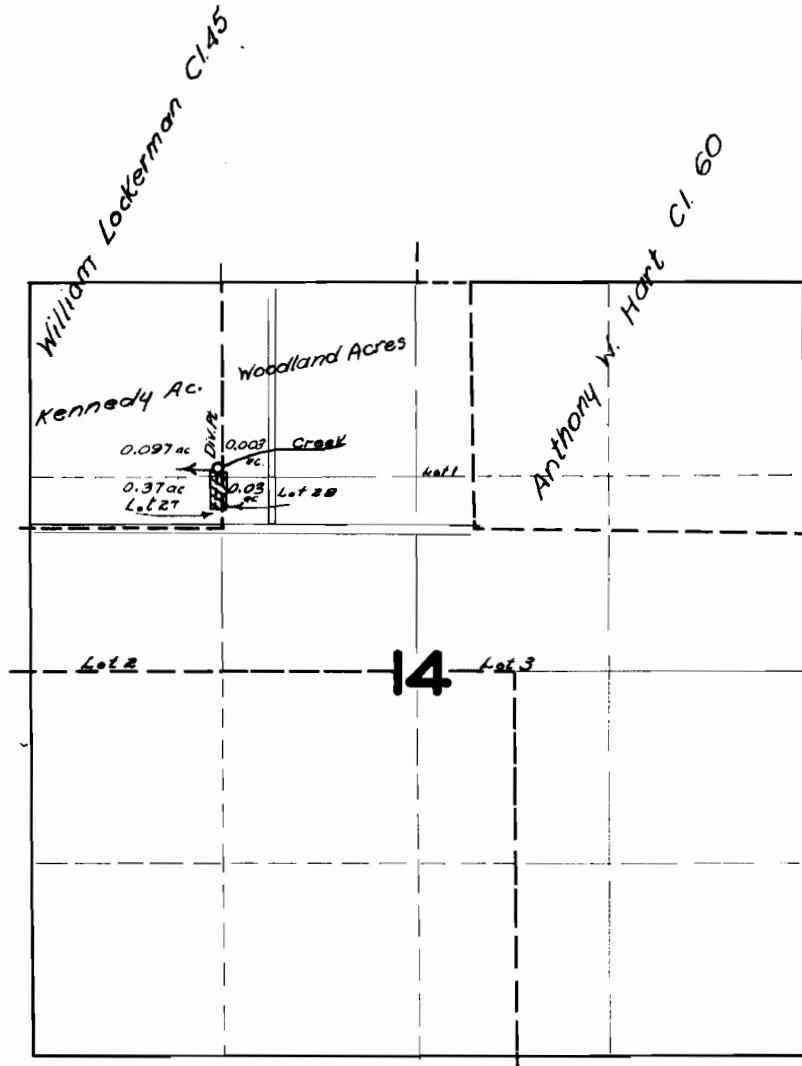

## FINAL PROOF SURVEY

UNDER

Application No. 24865 Permit No. 19565

IN NAME OF

HENRY J. DURDEL

Surveyed 4 / 25 19 52, by H. L. COFFMAN