


T.6S.R.1E.W.M.

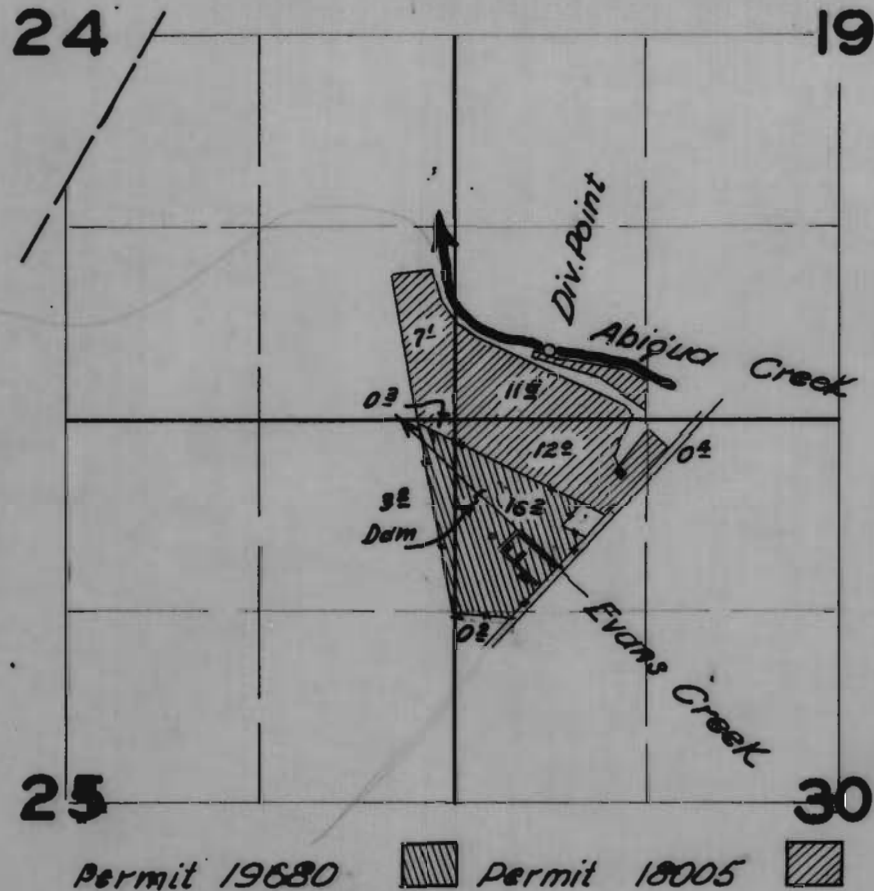

FINAL PROOF SURVEY

UNDER

24884

19680

Application No. 22789 Permit No. 18005

IN NAME OF

VERNE G. HISKEY AND J. M. DE HART

Surveyed Aug. 22 19 52, by H. L. COFFMAN