


T.2N.R.5W.W.M.

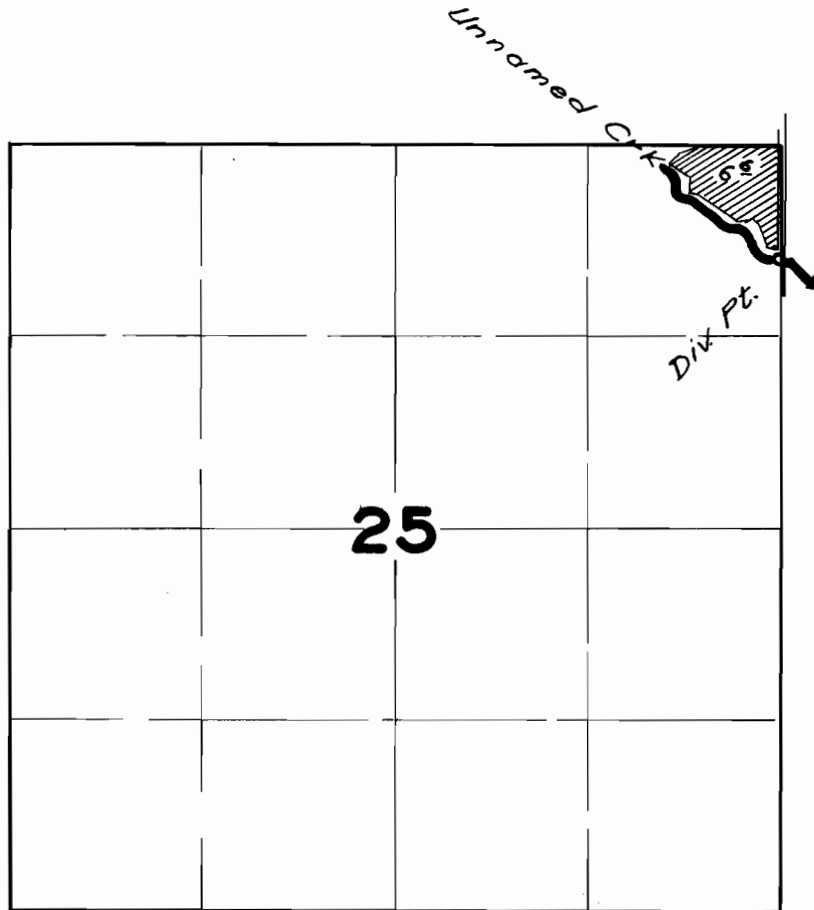

FINAL PROOF SURVEY
UNDER

Application No. 25049 Permit No. 19731

IN NAME OF

MELVIN N. OBERG

Surveyed 7 / 15 1952, by H. L. COFFMAN