T.2S. R.2W.W.M.

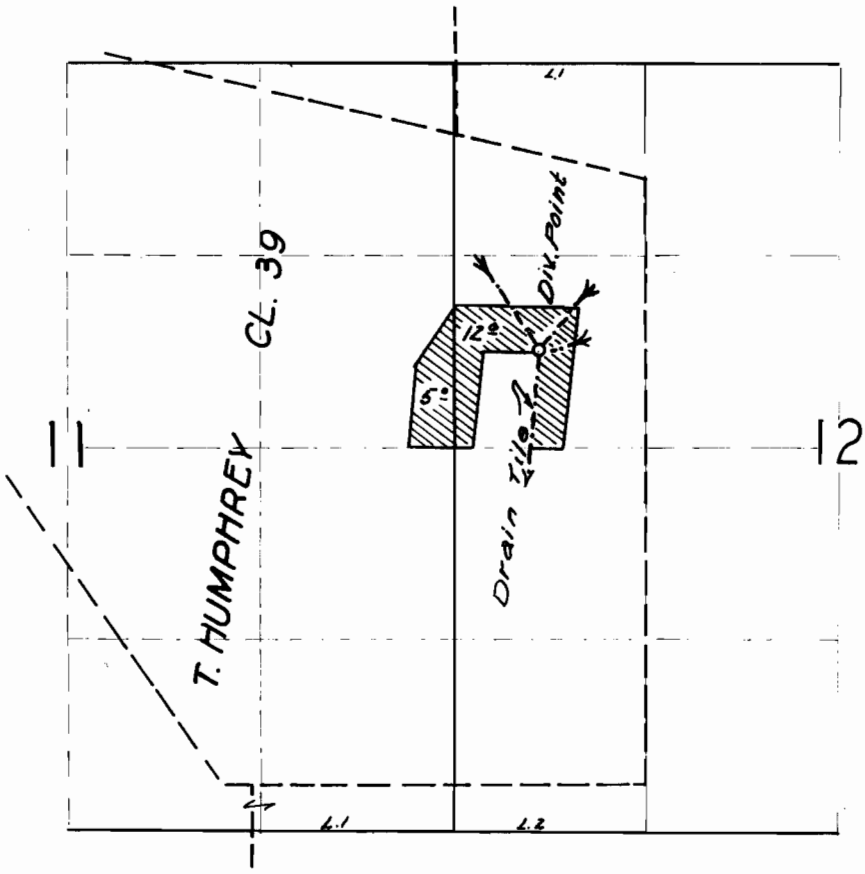

FINAL PROOF SURVEY

UNDER

Application No. 25035 Permit No. 19722

IN NAME OF

J. H. ATEN

Surveyed 5 / 7 1952, by H. L. COFFMAN

1952 B