


T. IN. R. 4 W. W. M.

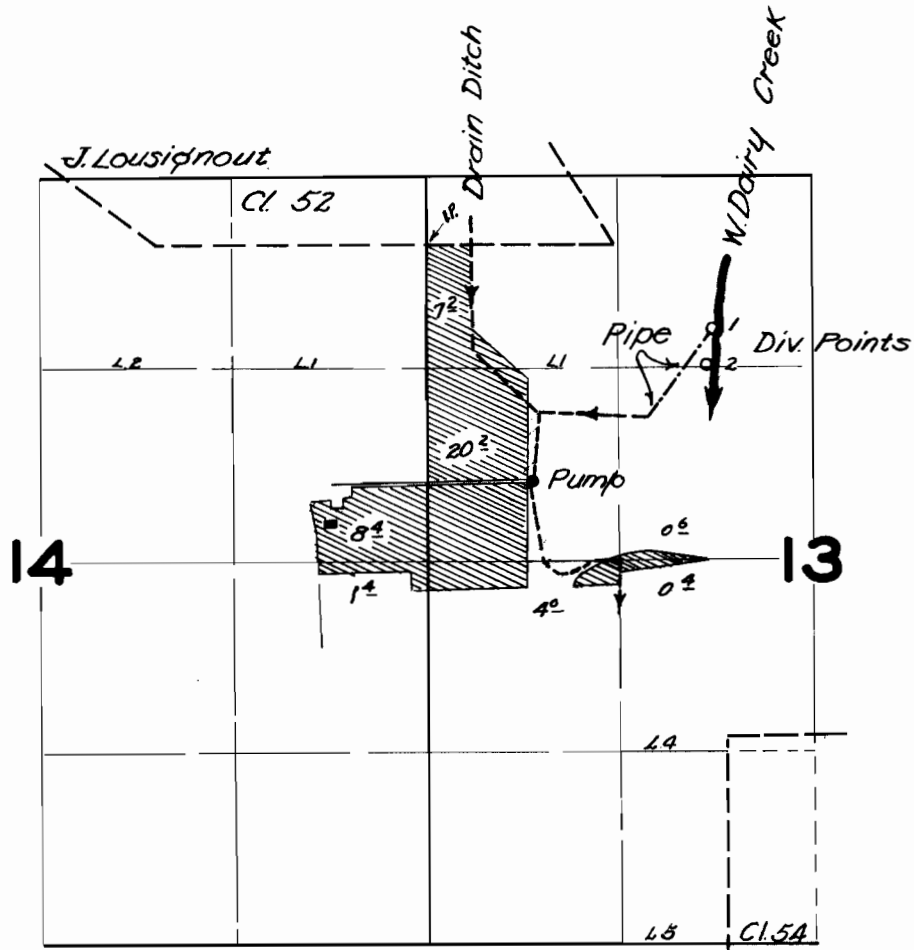

FINAL PROOF SURVEY UNDER

Application No. 25050 Permit No. 19732
IN NAME OF

ERNEST HEESACKER

Surveyed 7 / 18 1952, by H. L. COFFMAN