


T.1N.R.2W.W.M.

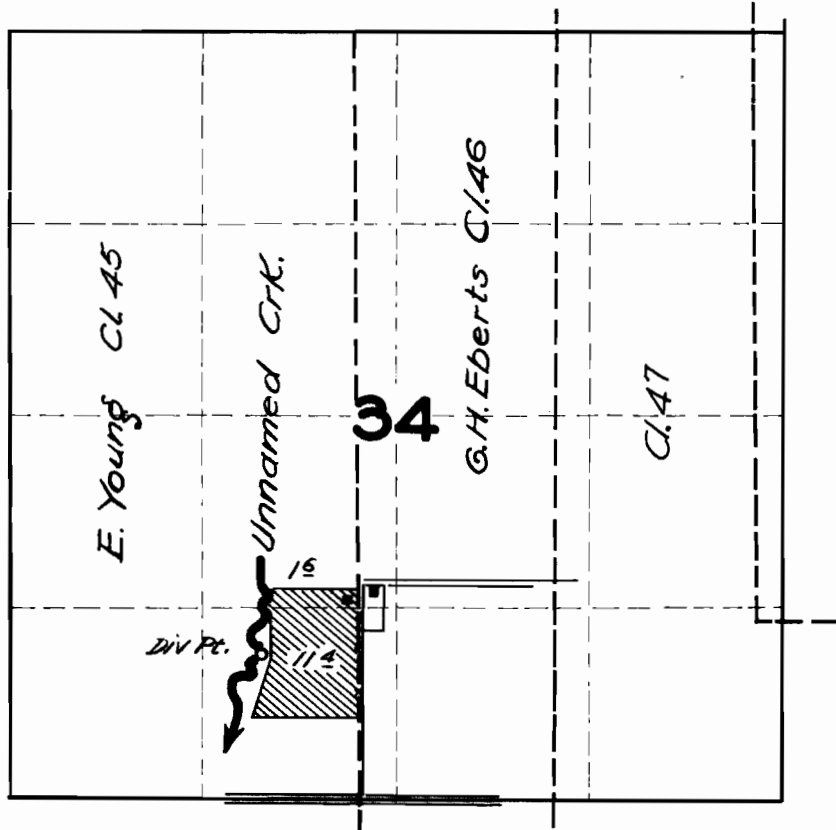

**FINAL PROOF SURVEY**

UNDER

Application No. 25250 Permit No. 19836

IN NAME OF

LOU H. WEATHERS

Surveyed June 4, 1952, by H. L. COFFMAN