


T. 1N. R. 4W. W.M.

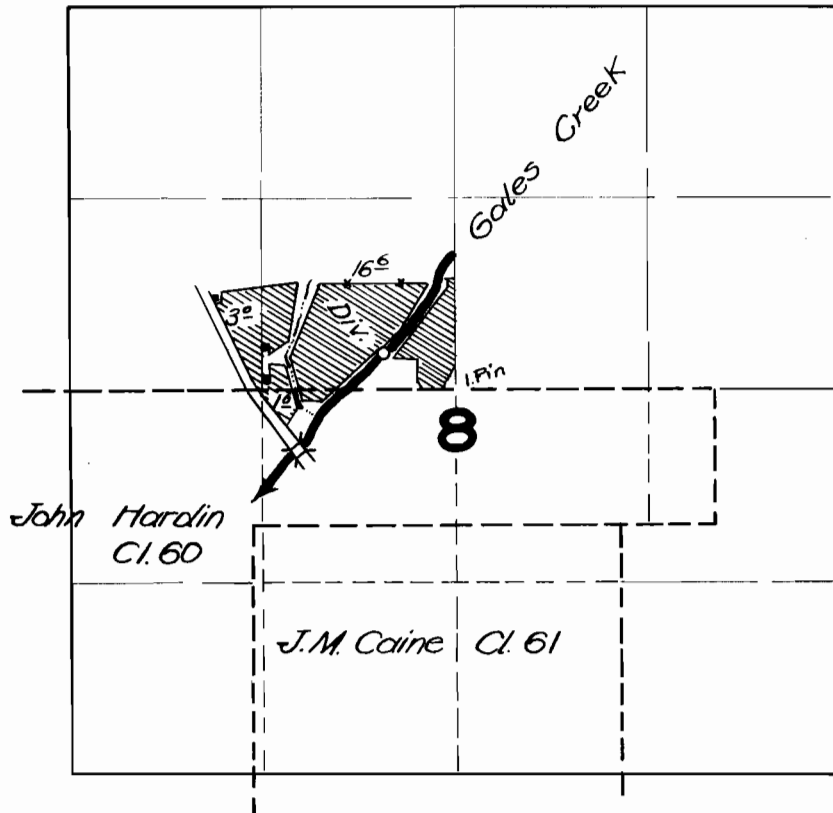

FINAL PROOF SURVEY

UNDER

Application No. 25108 Permit No. 12950

IN NAME OF

EMIL C. DOBER

Surveyed 7 / 11 19 52, by H. J. CONNOR