


T.I.S.R.3W.W.M.

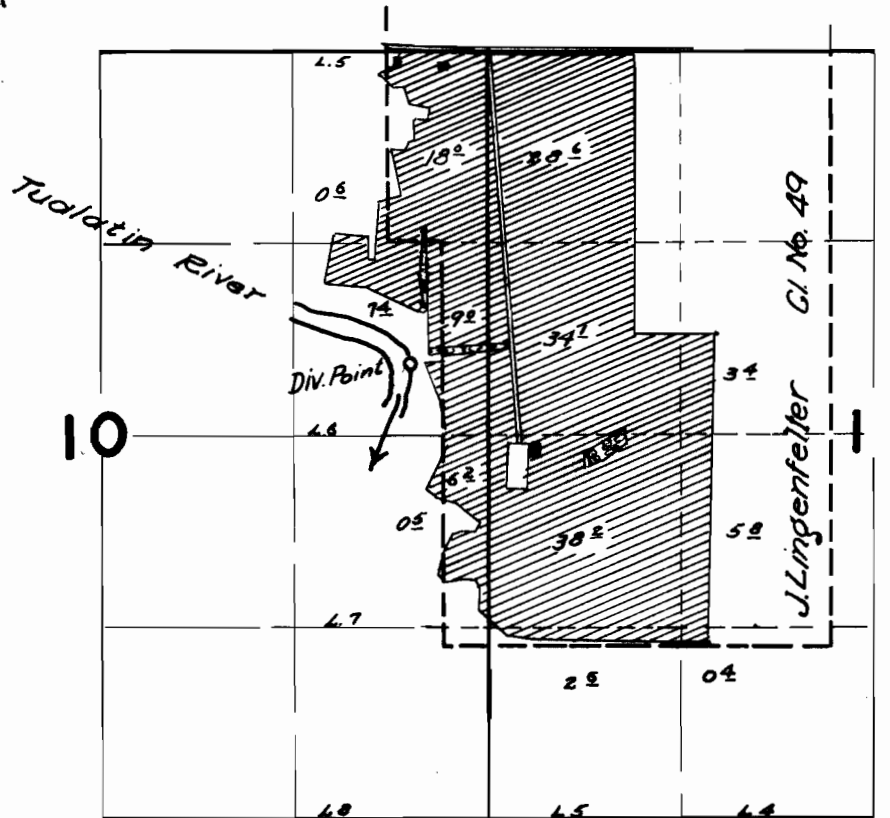

FINAL PROOF SURVEY

UNDER

Application No. 25281 Permit No. 19853

IN NAME OF

EUGENE F. McCORNACK

Surveyed May 20, 1952, by H. L. COFFMAN