


T.IN.R.3 W.W.M.

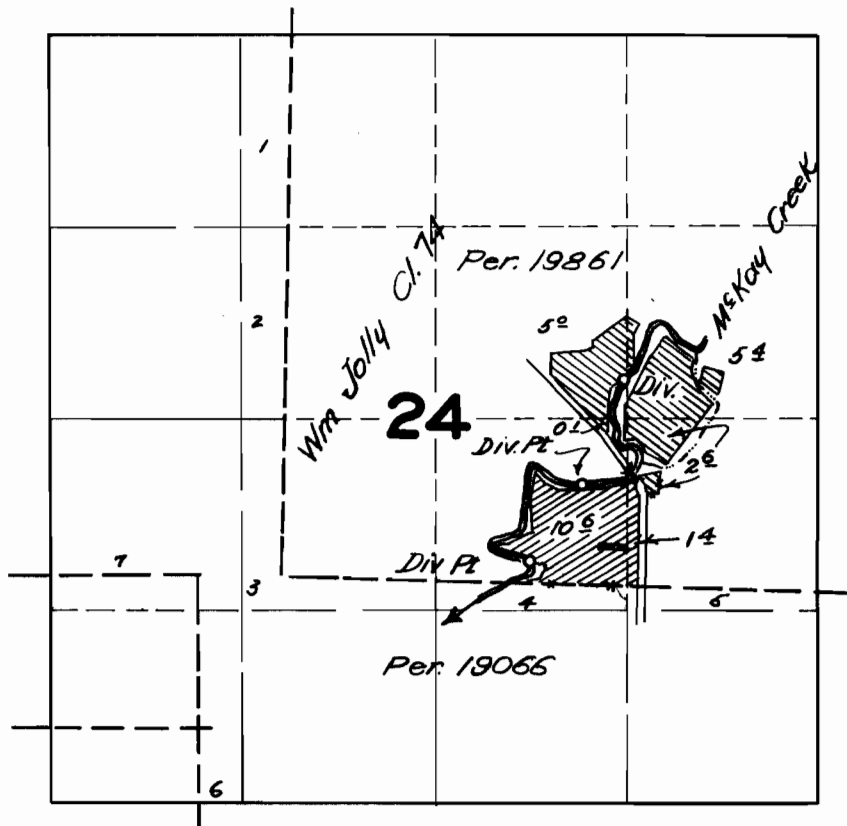

FINAL PROOF SURVEY

UNDER

Application No. 24329 25306 Permit No. 19066 19861

IN NAME OF
WILLIAM M. REEDY
J. A. JAROSS

Surveyed 6 / 12 19 52, by H.L. COFFMAN