


T.7S.R.2W.W.M.

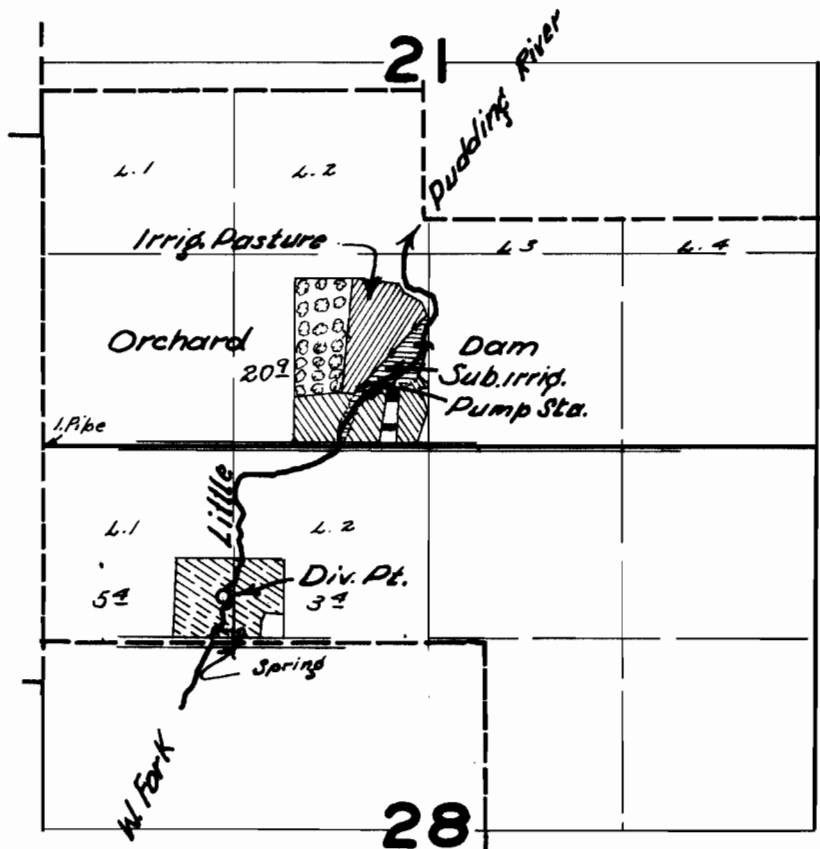

Permit 14647  
 Permit 25369

FINAL PROOF SURVEY

UNDER  
 19011 19017  
 Application No. 25369 Permit No. 19085  
 IN NAME OF  
 L. C. FICKE, & LAWRENCE A. & CLARA MAY DAINGER  
 Surveyed August 7 1952 by H. A. GUTHRIE