


T.2S.R.2W.W.M.

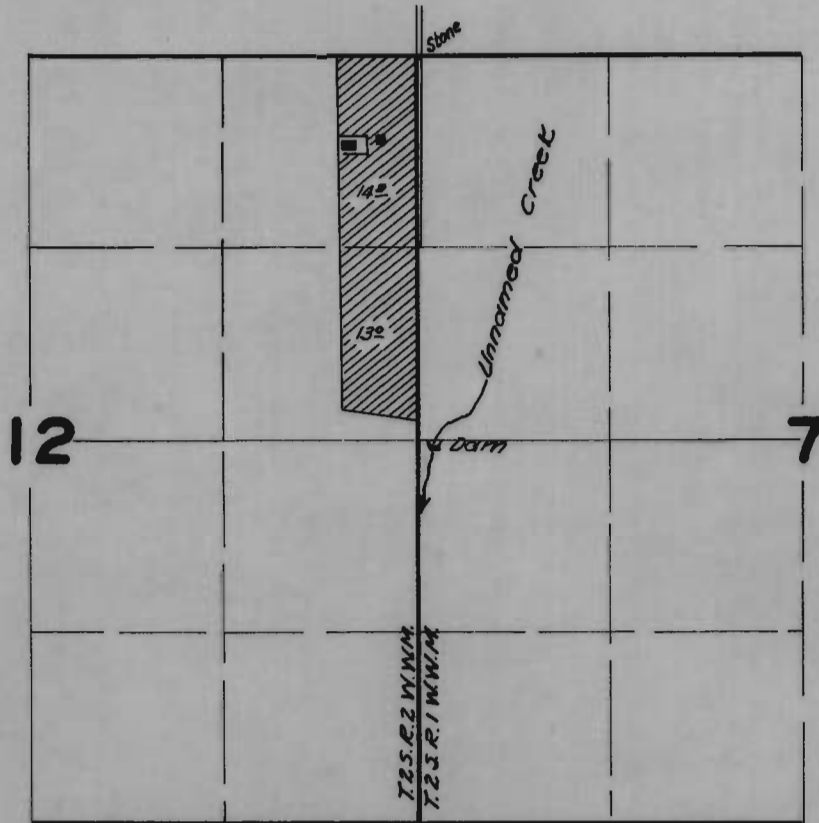

FINAL PROOF SURVEY UNDER

Application No. 25409 Permit No. 19895
IN NAME OF

FRED B. GRABHORN

Surveyed 5 / 1 1952, by H. L. COFFMAN