


T.2 S.R.2W.W.M.

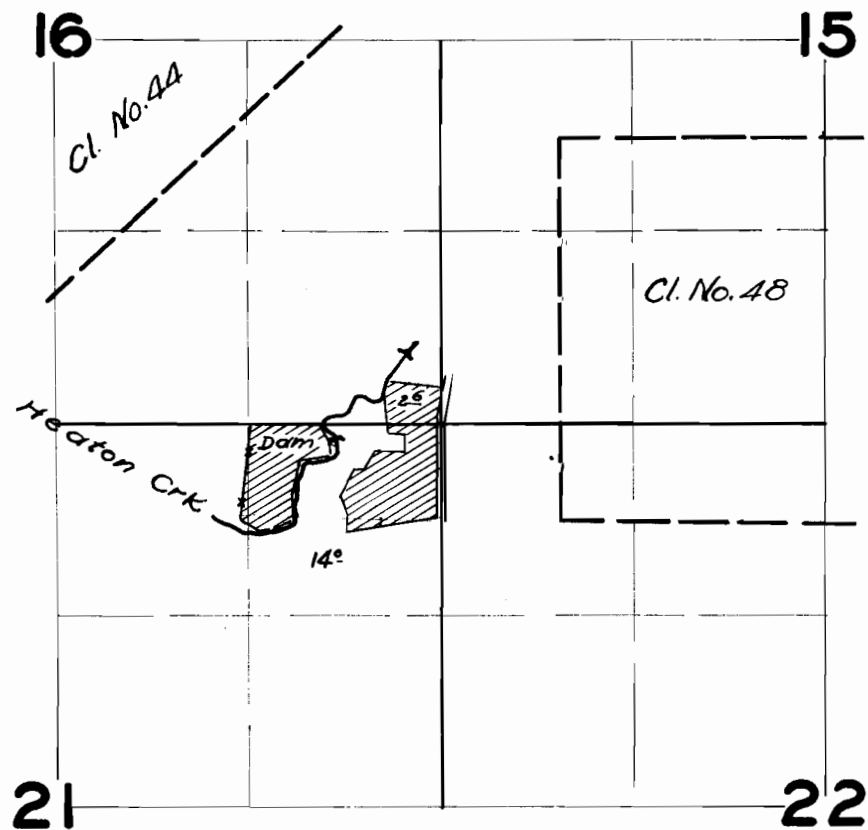

FINAL PROOF SURVEY

UNDER

Application No. 25665 Permit No. 20124

IN NAME OF

E. L. SEIFFERT

Surveyed 5 / 1 1952, by H. L. COFFMAN