


T. I. S. R. 3 W. W. M.

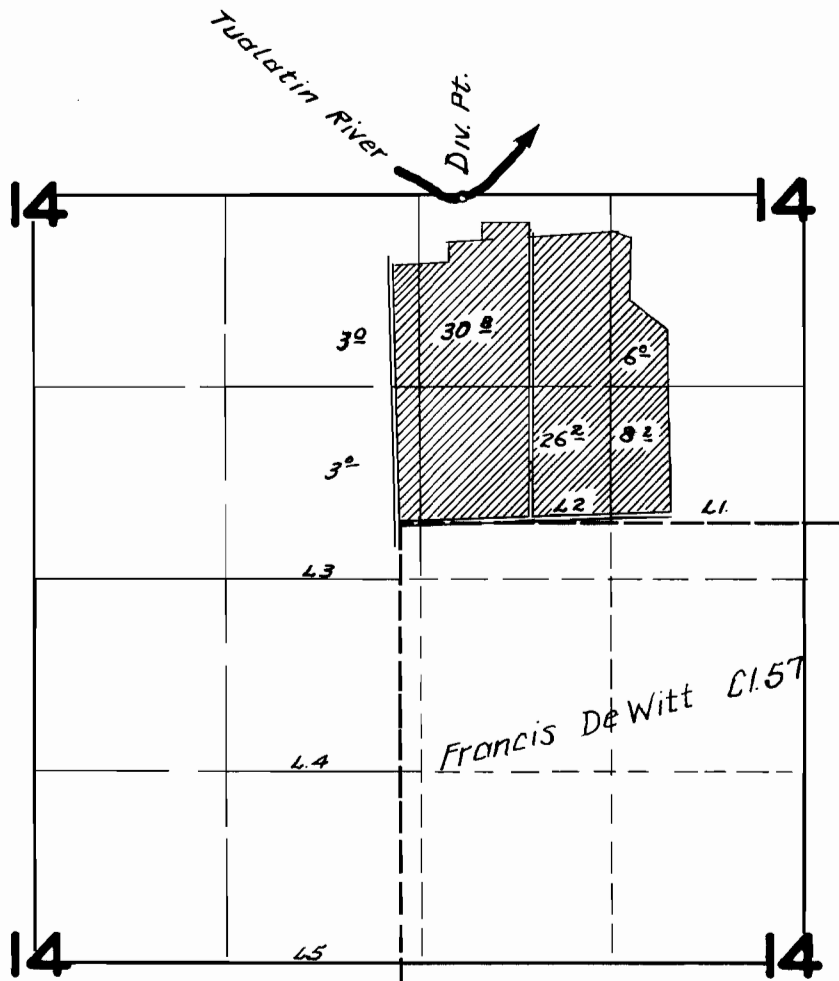

FINAL PROOF SURVEY UNDER

Application No. 25580 Permit No. 20078
IN NAME OF

F. H. BOWLBY and SONS

Surveyed 7 / 18 1952, by H. L. COFFMAN