


T. 2 S. R. 1 W. W. M.

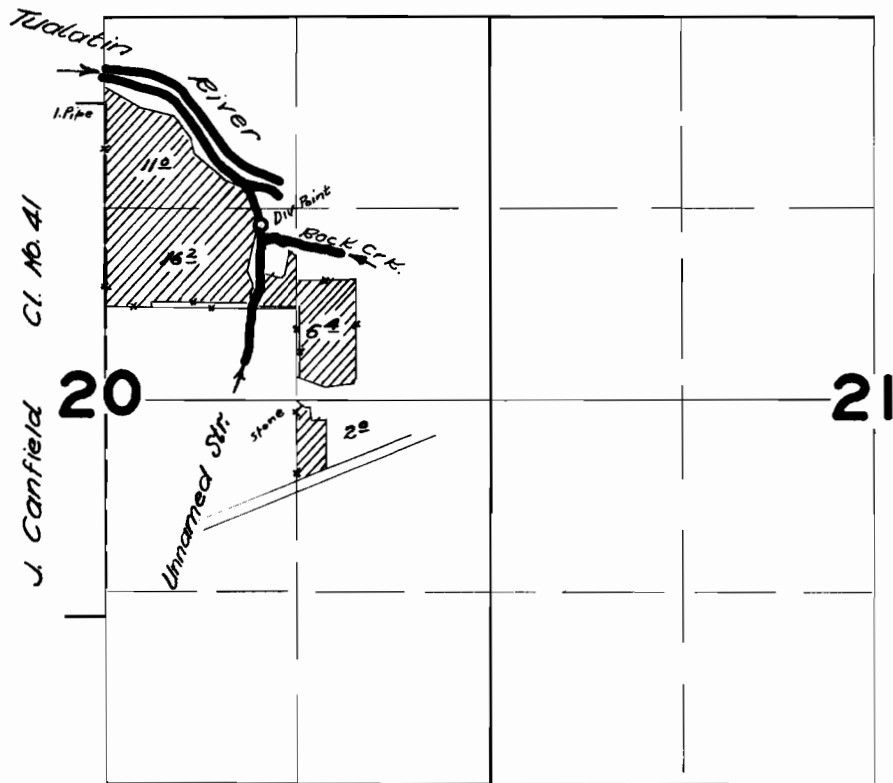

FINAL PROOF SURVEY

UNDER

Application No. 25686 Permit No. 20134

IN NAME OF

JOSEPH S. GRIMSTAD

Surveyed 4 / 28 1952 by H. L. COFFMAN