


T.3S.R.1W.W.M.

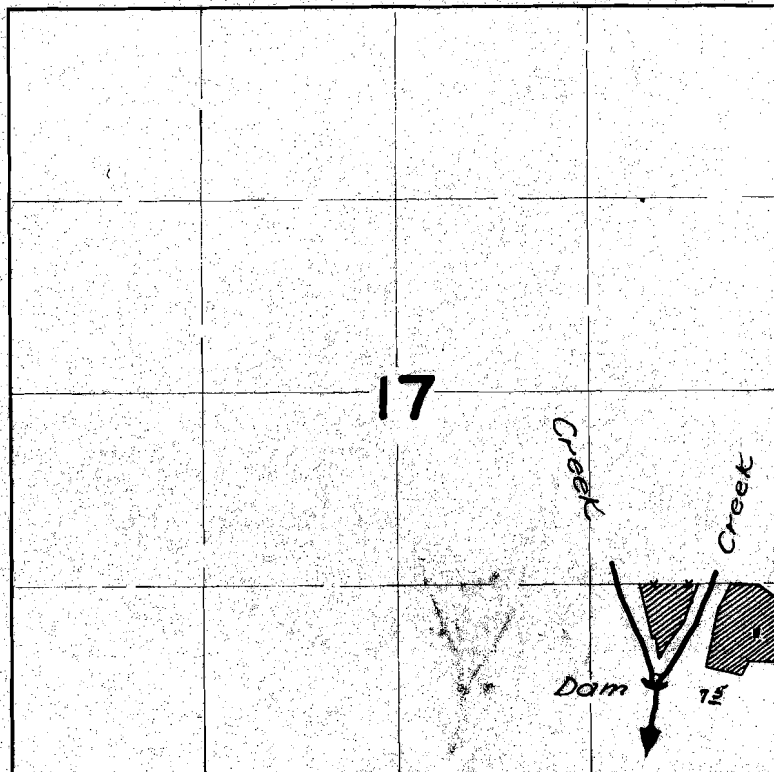

FINAL PROOF SURVEY

UNDER

R-2621h

R-1233

Application No. 2621h Permit No. 206003

IN NAME OF

CYRIL J. STEYAERT

Surveyed 7 / 25 1952, by H. L. COFFMAN

1952 E