


T. IN. R. 2 W. W. M.

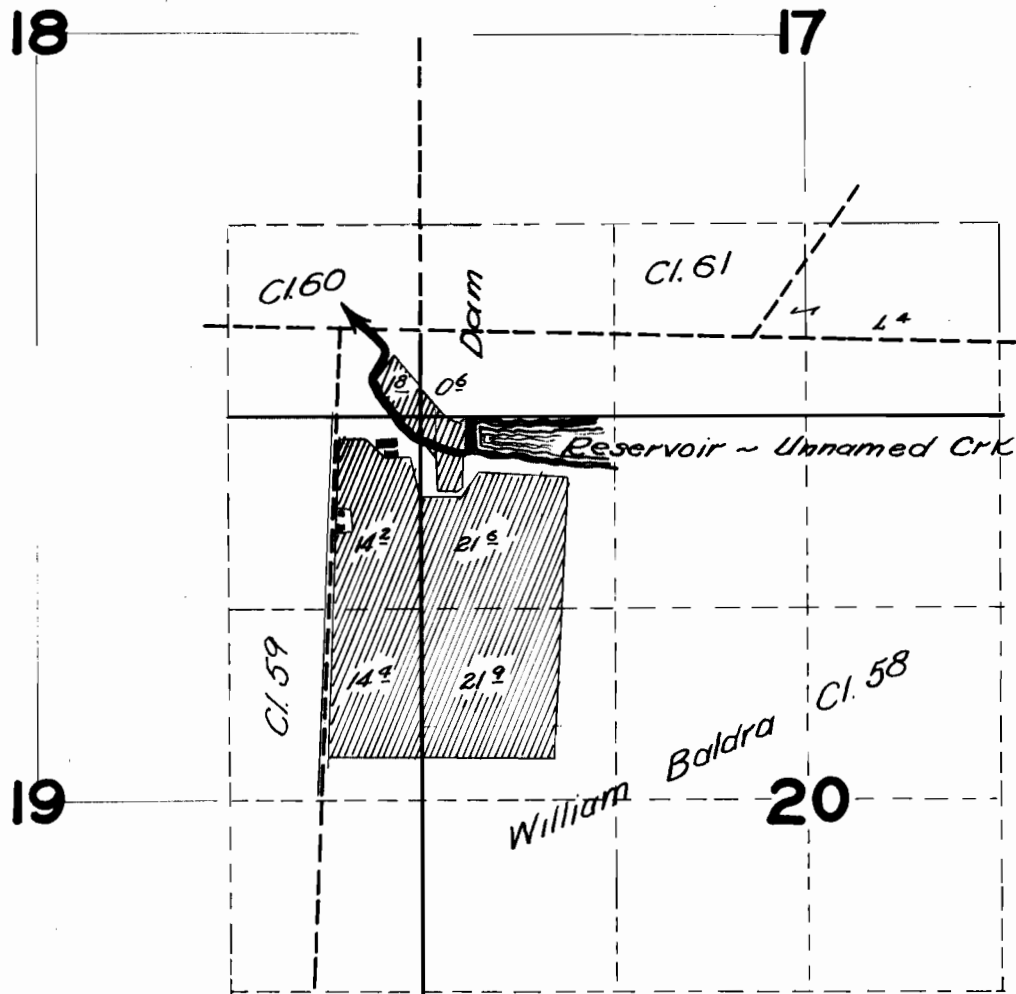

FINAL PROOF SURVEY

UNDER

Application No. 26232 Permit No. 20603

IN NAME OF

BERT VANDERZANDIEN

Surveyed 7 / 21 1952, by H. L. COFFMAN