


# T.I.S.R.2 W.W.M.

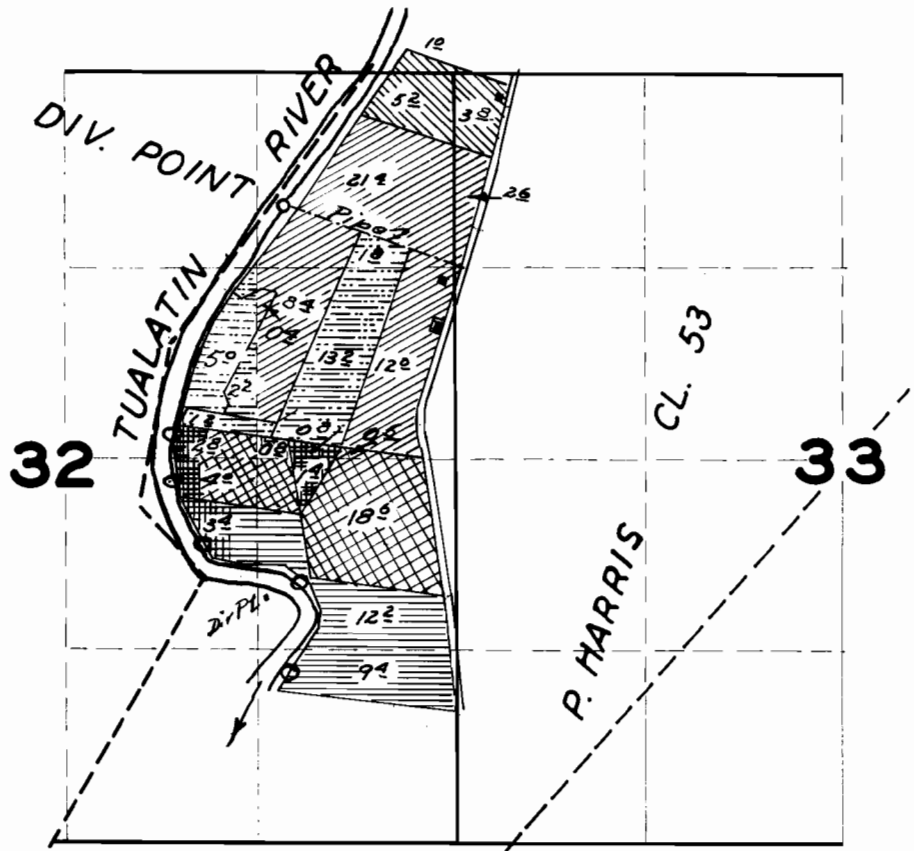

## FINAL PROOF SURVEY

file	DAVID RICH	APP. 16695	PER. 12483	
	DAVID RICH	APP. 25668	PER. 20127	
	C. MOWLDS	APP. 16695	PER. 12483	
	E. COWGILL	APP. 16695	PER. 12483	
	E. COWGILL	APP. 27104	PER. 21327	
	F. COWGILL	APP. 16695	PER. 12483	

Surveyed 5 / 6 1952, By H. L. COFFMAN