


T. 36 S., R. 5 W., W.M. .

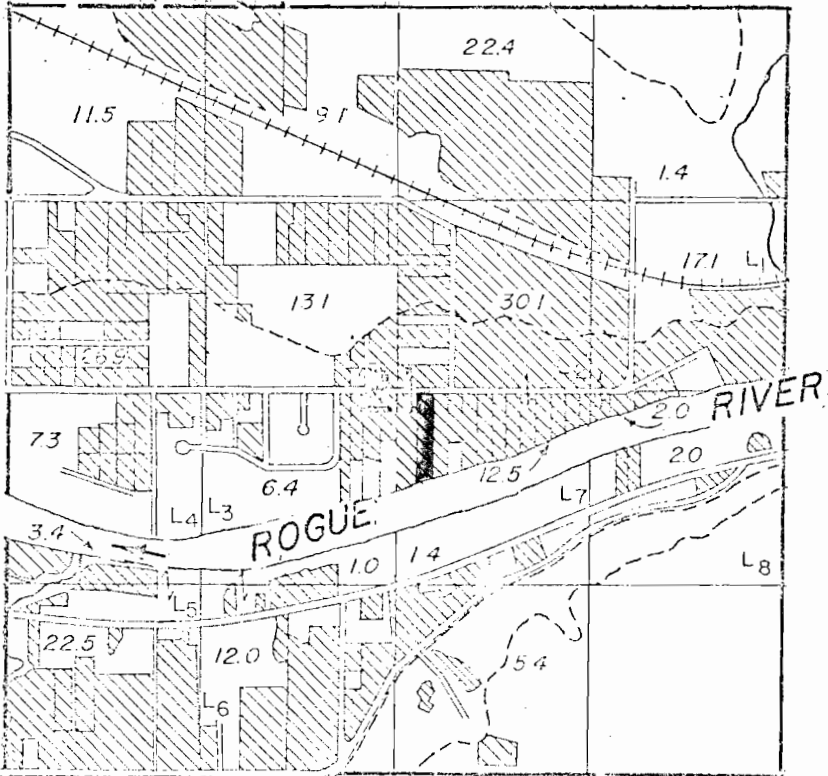

FINAL PROOF SURVEY
UNDER

Application No. 5189 Permit No. 8853

IN NAME OF

Grants Pass Irrigation District

Surveyed 19....., by W.R.D.