


# T. 9 S. R. 2 W. W. M.

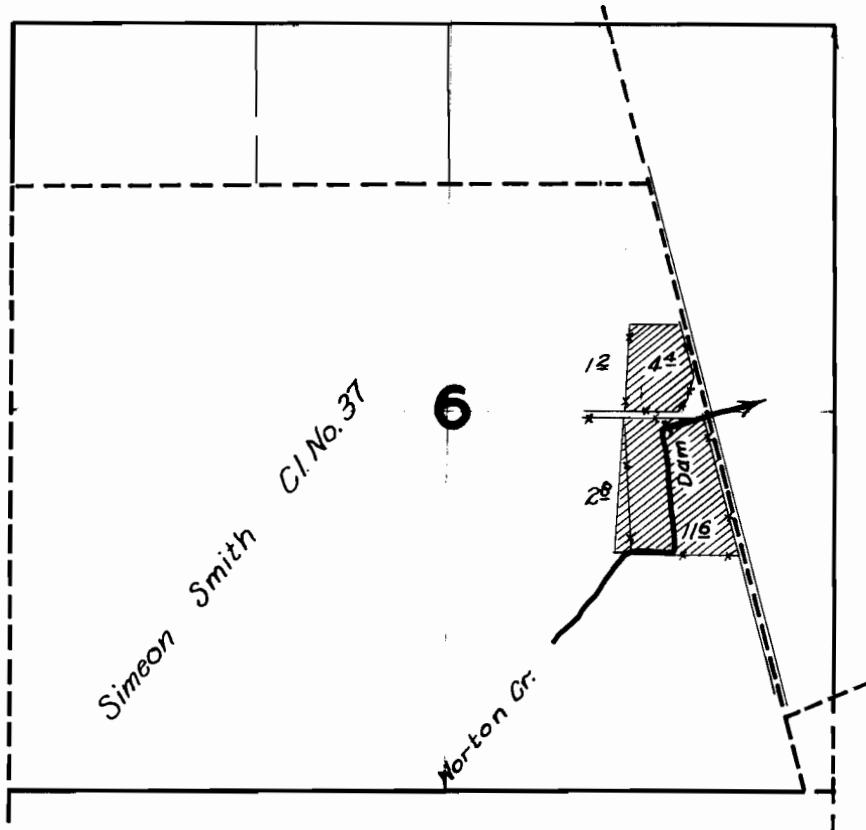

## FINAL PROOF SURVEY

UNDER

Application No. 17582 Permit No. 13279

IN NAME OF

JOHN PETERSEN

Surveyed July 30, 1952, by H. I. Coffman