


# T.7S.R.2W.W.M.

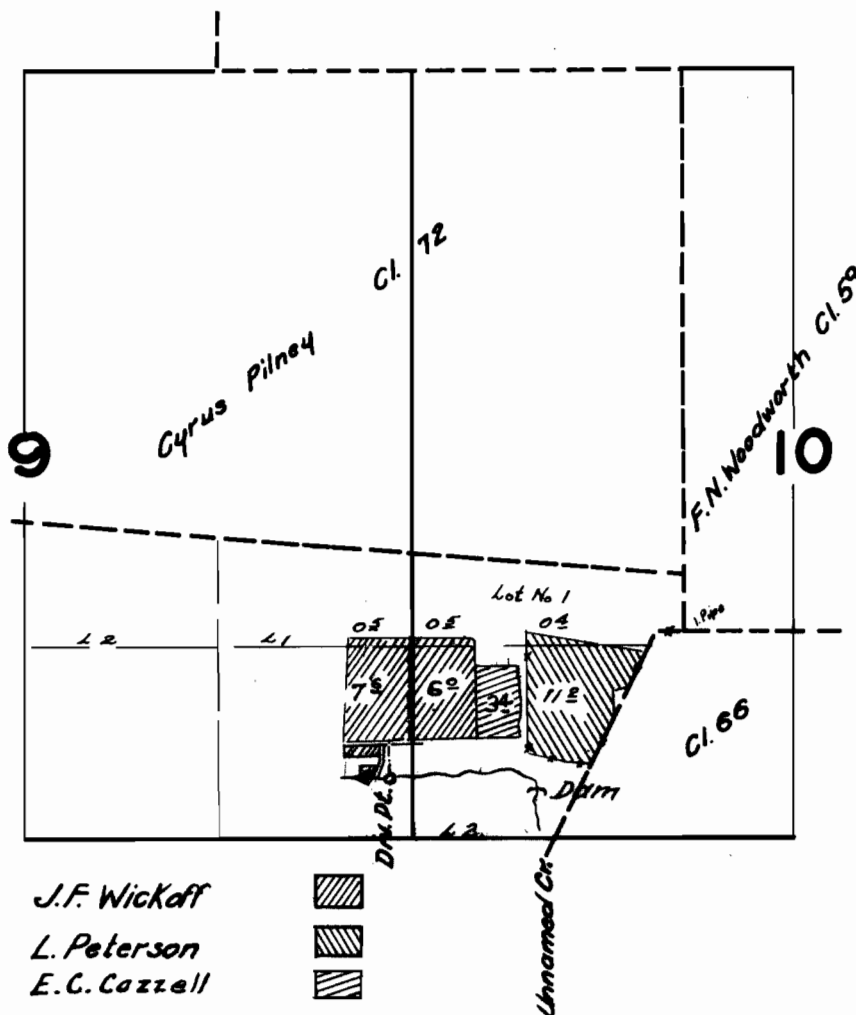

## FINAL PROOF SURVEY

UNDER

18120

13772

Application No. 22227

Permit No. 17539

IN NAME OF

E. C. CAZZELL - J. F. WICKOFF - LEONARD PETERSON

Surveyed August 4 1952, by H. L. COFFMAN