


T.7S.R.2W.W.M.

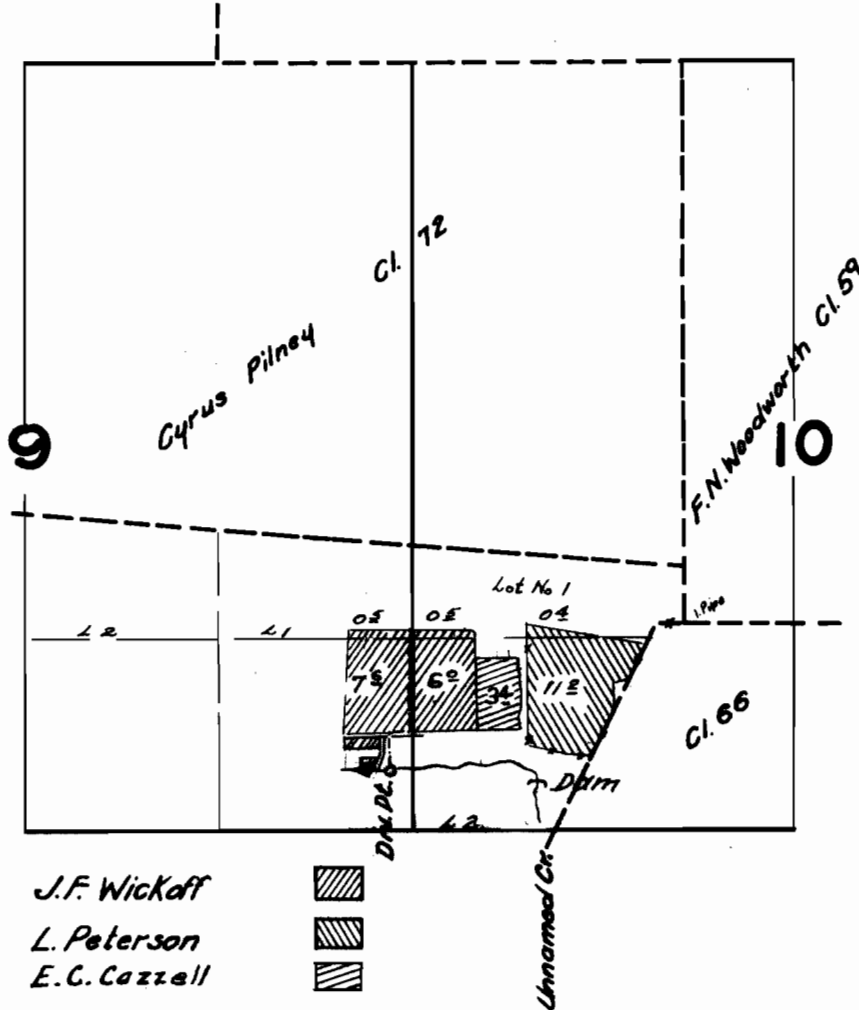

J.F. Wickoff
 L. Peterson
 E.C. Gazzell



FINAL PROOF SURVEY

UNDER

18120

13772

Application No. 22227

Permit No. 17539

IN NAME OF

E. C. GAZZELL - J. F. WICKOFF - LEONARD PETERSON

Surveyed August 4 1952, by H. L. COFFMAN