


T.6 S. R. I. W. W. M.

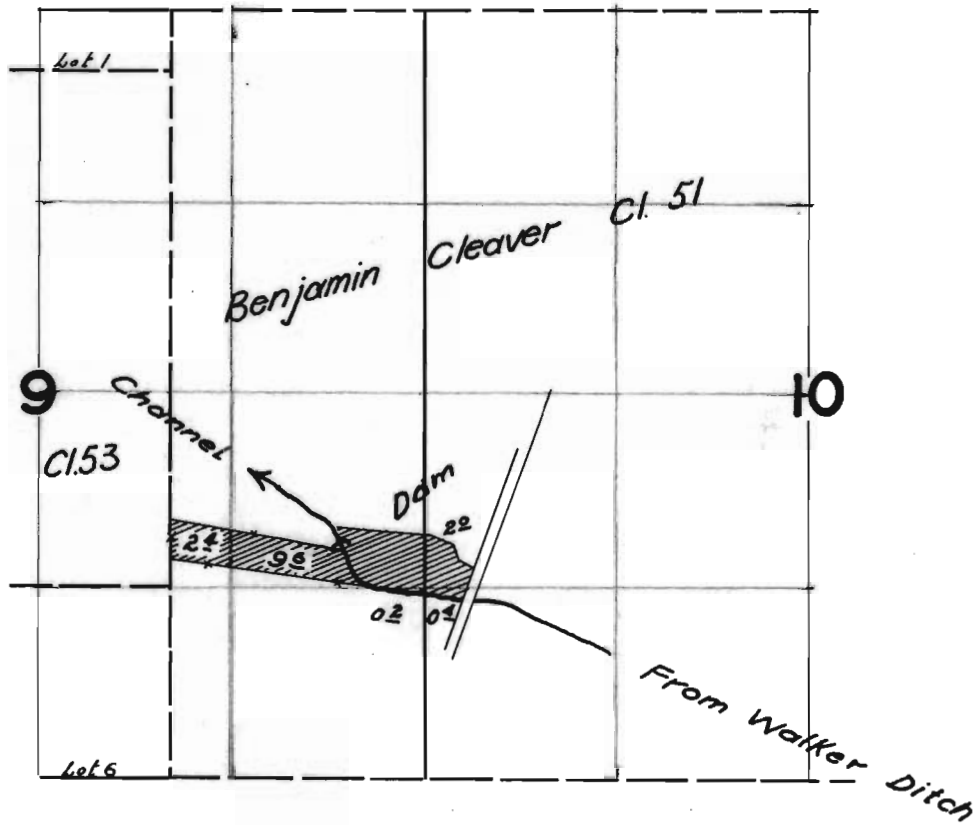

FINAL PROOF SURVEY

UNDER

Application No. 22374 Permit No. 17640

IN NAME OF

BERNT BROTHERS

Surveyed Aug. 22 19 52 by H. L. COFFMAN