


T.5S.R.1W.W.M.

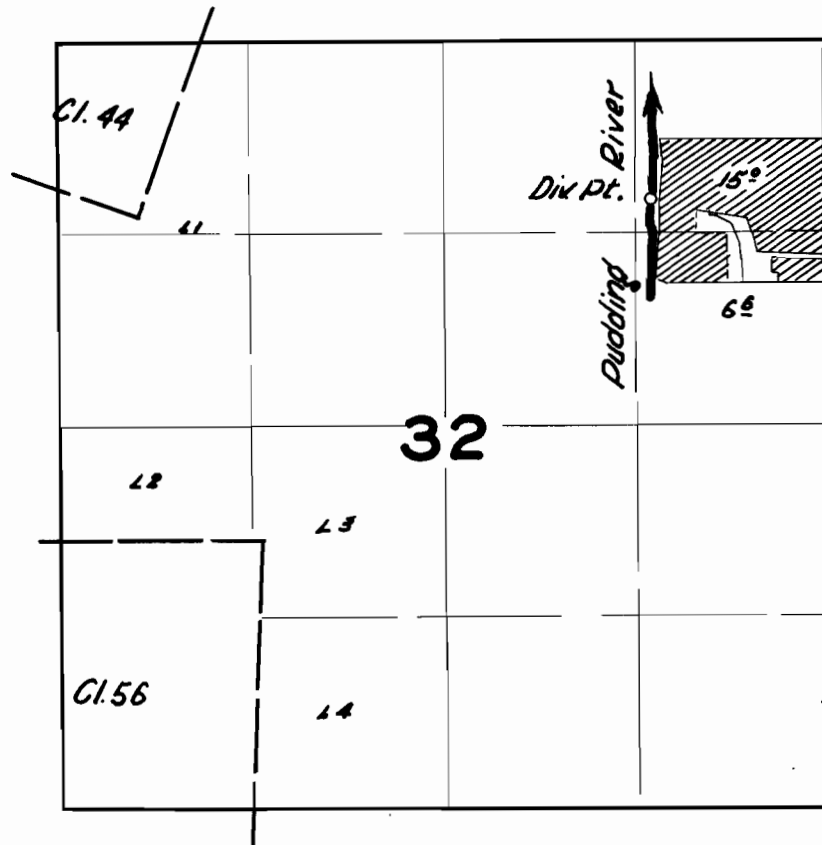

FINAL PROOF SURVEY

UNDER

Application No. 22339 Permit No. 17611

IN NAME OF

JOE C. WAGNER

Surveyed Aug. 25 1952, by H. I. COFFMAN