


T. 7 S. R. 1 W. W. M.

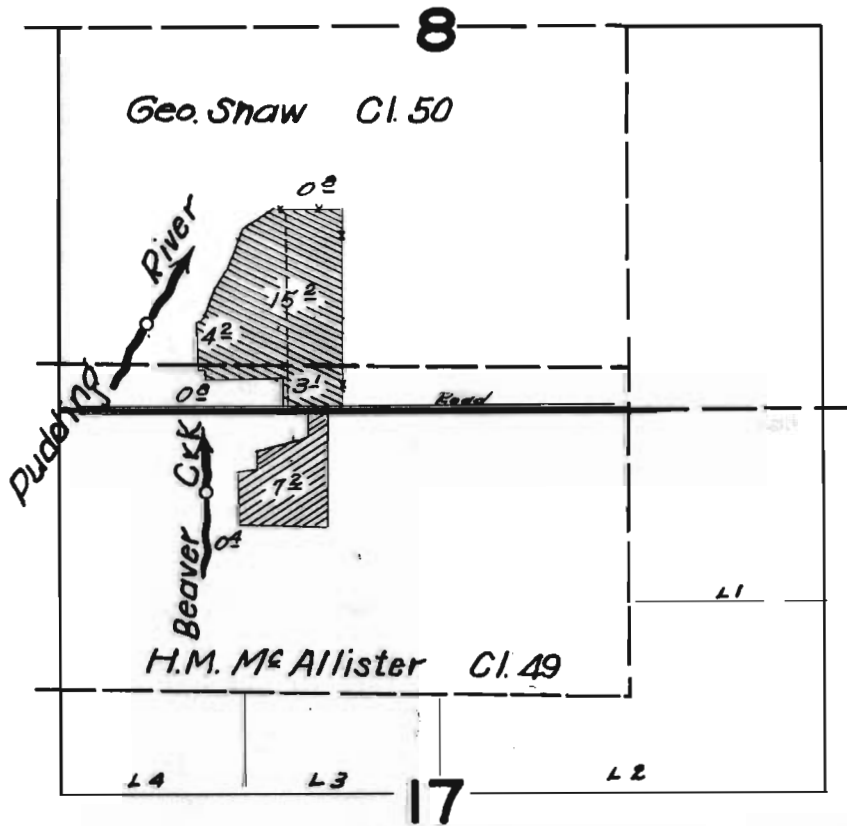

Permit 17823  Permit 17822  Cancelled

FINAL PROOF SURVEY

UNDER

Application No. ~~22563~~ ²²⁵⁶⁴ Permit No. ~~17822~~ ¹⁷⁸²³

IN NAME OF

BEN KAUFMAN

Surveyed Aug. 12, 1952, by H. L. COFFMAN