


T.7S.R.2 W.W.M.

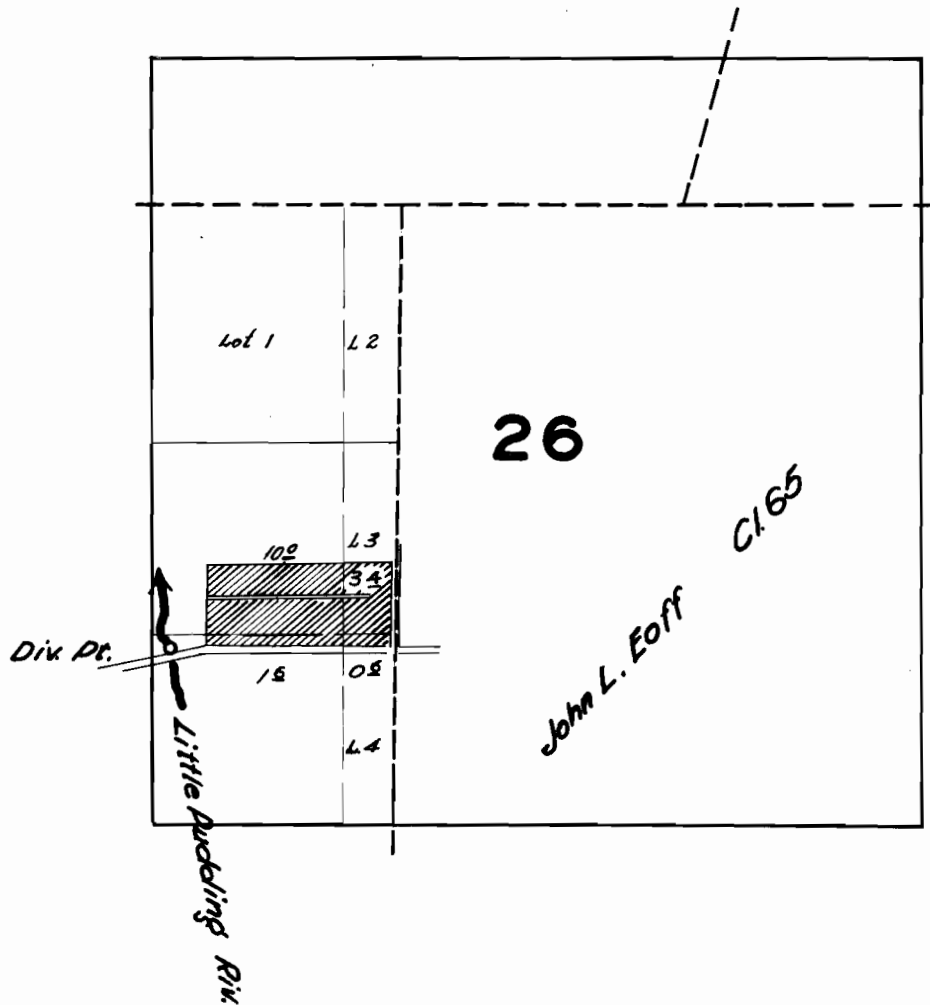

FINAL PROOF SURVEY

UNDER

Application No. 24615 Permit No. 19924

IN NAME OF

EUGENE HAMRICK

Surveyed August 6 1952, by H. L. COFFMAN