


T.6 S.R.3 W.W.M.

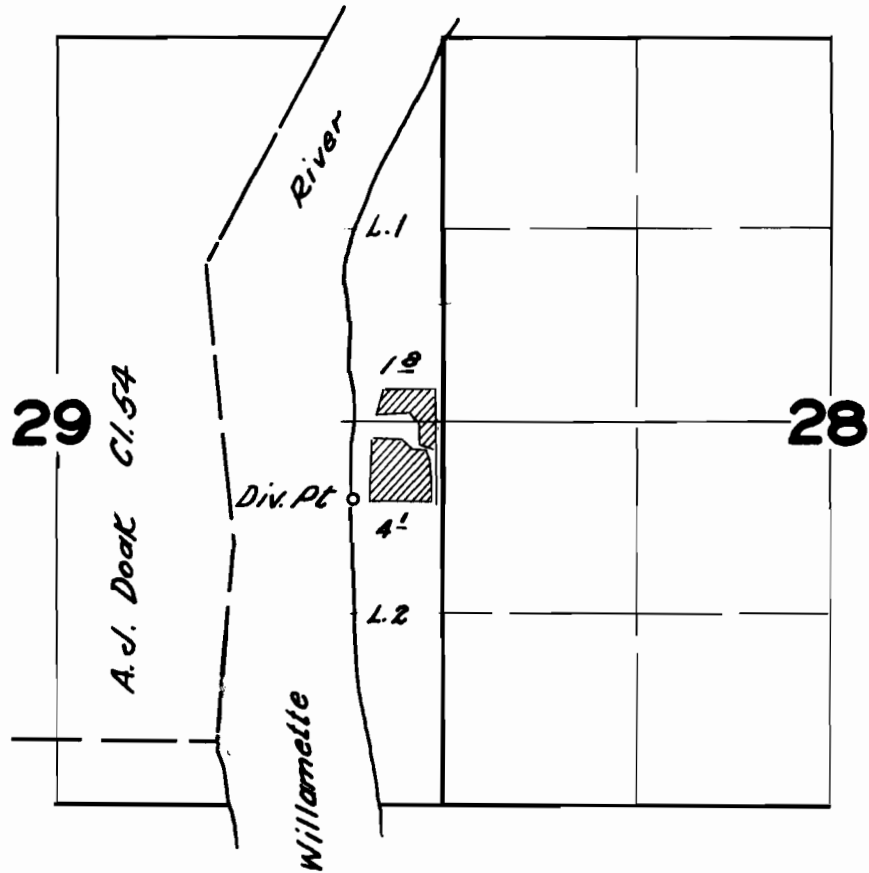

FINAL PROOF SURVEY

UNDER

Application No. 25479 Permit No. 20026

IN NAME OF

IRVING W. SNYDER

Surveyed Aug. 27 1952, by H. L. COFFMAN